

PRELIMINARY TEMESCAL COMMERCIAL INFILL DEVELOPMENT SEWER AREA STUDY

RIVERSIDE COUNTY, CA

December 2023

PREPARED BY:

Kimley-Horn and Associates, Inc.
1100 W Town and Country Rd, Suite 700
Orange, CA 92868

PREPARED FOR:

MCP Industries, Inc.
4350 Von Karman Ave
Newport Beach, CA 92660



KHA Project # 194053006
© 2023 Kimley-Horn and Associates, Inc.

TABLE OF CONTENTS

CHAPTER 1	INTRODUCTION.....	1-1
	PURPOSE.....	1-2
CHAPTER 2	DESIGN CRITERIA.....	2-1
CHAPTER 3	STUDY AREA AND PROJECTED FLOWS.....	3-1
	Study Area.....	3-1
	Projected Flows.....	3-1
CHAPTER 4	EXISTING SEWER FACILITIES.....	4-1
CHAPTER 5	ULTIMATE SEWER SYSTEM REQUIREMENTS.....	5-1
	Gravity Sewer Lines.....	5-1
	Existing Condition.....	5-1
	Ultimate Condition.....	5-2
CHAPTER 6	CONCLUSION.....	6-1
APPENDIX A	AUGUST 2008 LEE LAKE WATER DISTRICT SEWER SYSTEM FACILITY REQUIREMENTS	
APPENDIX B	GRAVITY SEWER HYDRAULIC ANALYSIS	
APPENDIX C	FIGURES	
APPENDIX D	AS-BUILT RECORD DRAWINGS FOR EXISTING SEWER LINES	

LIST OF TABLES

TABLE 2-1	SEWAGE GENERATION FACTORS.....	2-1
TABLE 3-1	SEWER GENERATION PEAK FLOW.....	3-1

LIST OF FIGURES

FIGURE 1	TEMESCAL CANYON CONCEPTUAL SEWER STUDY EXHIBT	
----------	---	--

CHAPTER 1

INTRODUCTION

The proposed development “Temescal Commercial” is located south of the city of Corona, west of interstate 15, and at the cross-sections of Temescal Canyon Road and Lawson Road. The entire site is within the Design Theme Policy Area in the Temescal Canyon Area Plan of the Riverside County Integrated Project (RCIP). The project site is designated as a Commercial Tourist land use and zoned as Scenic Highway Commercial (C-P-S).

The Temescal Commercial Project is comprised of a proposed Light Industrial/Commercial lot identified as “Lot 1” on the enclosed Conceptual Sewer Study Exhibit and two undeveloped areas that are located south of Lot 1 that are designated as “Open Space.” (Conceptual Sewer Study is enclosed in Appendix C.)

The Temescal Commercial will be tied into the existing Temescal Valley Water District (TVWD – formerly Lee Lake Water District) sewer line in Temescal Canyon Road through the proposed gravity sewer lines along Temescal Canyon Road.

PURPOSE

The purpose of this study is to determine the required capacity of this project and corresponding pipelines necessary to support this development for the ultimate condition. In addition to this, a gravity sewer hydraulic analysis was performed to evaluate the demand and capacity of the proposed and existing sewer main lines per TVWD sizing standards.

CHAPTER 2

DESIGN CRITERIA

This chapter presents the design criteria used to evaluate sewer system facility sizing in this report. Unless otherwise noted, the criteria utilized in this report is in accordance with the August 2008 Lee Lake Sewer District Sewer System Facility Requirements, see Appendix A.

To convert land uses to projected average daily flows, the sewer generation factors provided in Table 2-1 were utilized. To convert average flows to peak flows, the peaking factor curve provided in Appendix A was utilized.

Table 2-1 Sewage Generation Factors	
Land Use	Generation Factors
Industrial	2,000 gpd/Ac*

* Generation Factors per Lee Lake Water District Sewer System Facility Requirements (2008)

All gravity sewers have been designed to convey peak wet weather flow with a minimum velocity of 2.0 feet per second and a maximum velocity of 8.0 feet per second. For pipes with a diameter of 10-inches and smaller, the sewers have been designed to convey this flow when flowing half full. For pipes with a diameter of larger than 10-inches, the sewers have been designed to convey peak wet weather flow when flowing three-fourths full by depth. Manning's Equations with an “n” value of 0.013 was used to size all gravity sewers.

CHAPTER 3

STUDY AREA AND PROJECTED FLOWS

This chapter presents projected sewage flows from properties within the study area.

Study Area

Apart from the existing Mission Clay Products property, the properties within the study area are generally undeveloped. The proposed development plans and zoning for properties within the study area were utilized to determine ultimate projected sewer flows.

The total average flow (MGD) and total peak flow (MGD) generated by the Temescal Commercial project were considered in this report. The proposed gravity sewer lines will be constructed to tie into the existing 15-inch sewer line on Temescal Canyon Road.

Projected Flow

For the properties identified within the study area, Table 3-1 presents the projected average and peak sewage flows. The land use assumptions and/or source for the proposed development on these properties are footnoted on Table 3-1. The peak factor calculations were taken per Lee Lake Water District Sewer System Facility Requirements (2008), Appendix A. As shown, the projected ultimate average flow for the study area is 0.22 MGD. Using the peaking factor curve in Appendix A this results in a projected peak flow of 0.58 MGD.

TABLE 3-1 SEWER GENERATION PEAK FLOW						
Lot Number	LAND USE	LOT SIZE (AC)	GENERATION FACTOR	AVG GAL/DAY	AVG MGD	PEAK MGD
1	LIGHT INDUSTRIAL	10.80 ac	2,000 gpd/ac	21,600	0.022	0.057
2	OPEN SPACE	0.21 ac	0	0	0	0
3	OPEN SPACE	0.60 ac	0	0	0	0
-	*FUTURE CONNECTION #1 (WEST)	-	-	-	0.096	0.250
-	*INDUSTRIAL/SCHOOL FUTURE CONNECTION #2 (NORTH)	-	-	-	0.096	0.250
-	**COMMERCIAL FUTURE CONNECTION #3 (EAST)	-	-	-	N/A	N/A
					0.221	0.575

Refer to Figure 3 for the location map of the planning areas.

*Potential future calculated per maximum allowable flow.

** Potential future commercial connection is to Temescal Canyon Road

CHAPTER 4

EXISTING SEWER FACILITIES

All sewage within the District is conveyed to the TVWD Reclamation Facility for treatment and re-use. Flow is currently conveyed northerly to this facility in a 15-inch sewer main located in Temescal Canyon Road, per Appendix D.

15” Existing sewer lines run along Temescal Canyon Road serviced by Temescal Canyon Water District. There are no records of existing sewer lines within the project area.

CHAPTER 5

SEWER SYSTEM REQUIREMENTS

This chapter presents the recommended regional sewer facilities required to provide service to the properties within project area. The concept is to construct a new sewer line to tie into the existing 15-inch sewer line.

Gravity Sewer Lines

In the ultimate condition, it is proposed to construct a gravity sewer line to convey flows to the Temescal Valley Water District sewer line on Temescal Canyon Road. These pipe sizes are preliminary based on allowable flows and utilizing Flowmaster to estimate the proposed pipe size. Appendix B provides a hydraulic analysis of the sewer line sizing required to serve the lots shown in the Conceptual Sewer Study Exhibit, per Appendix C. Final sizing to be confirmed during final engineering.

At A1, Future Connection #1 has an assumed peak flow of 0.250 MGD based on surrounding acreage and land use. Using the Flowmaster application, the pipe size at A1 on the Conceptual Sewer Study Exhibit, per Appendix B, was sized to be 8", as it meets the TVWD criteria of having a minimum velocity of 2.0 feet per second while conveying this flow when flowing half full at a slope of 0.5%.

Similarly, at B1, Future Connection #2 has an assumed peak flow of 0.250 MGD based on surrounding acreage and land use. Using the Flowmaster application, the pipe size at B1 on the Conceptual Sewer Study Exhibit, per Appendix B, was sized to be 8", as it meets the TVWD criteria of having a minimum velocity of 2.0 feet per second while conveying this flow when flowing half full at a slope of 0.5%.

At A2, the peak flows from Future Connection #1 and Future Connection #2 sum up to 0.50 MGD. Using the Flowmaster application, the pipe size at A2 on the Conceptual Sewer Study Exhibit, per Appendix B, was sized to be 10", as it meets the TVWD criteria of having a minimum velocity of 2.0 feet per second while conveying this flow when flowing half full at 0.5%.

At A3, the peak flows from Future Connection #1, Future Connection #2, and the light industrial lot sum up to 0.56 MGD. Using the Flowmaster application, the pipe size at A3 on the Conceptual Sewer Study Exhibit, per Appendix B, was sized to be 10", as it meets the TVWD criteria of having a minimum velocity of 2.0 feet per second while conveying this flow when flowing half full at 4.9%.

CHAPTER 6

CONCLUSION

The projected ultimate average flow for the Temescal Commercial Project is 0.21 MGD, and the projected peak flow is 0.56 MGD. The total average flow was calculated through maximum allowable flows, project acreages, land uses, and sewer generation factors as shown in Table 3-1.

After the completion of the Temescal Commercial Project, the project will connect to the existing 15-inch Temescal Valley Water District sewer line. For reference, see Appendix C.

All proposed sewer mains are sized to meet the August 2008 Lee Lake Sewer District Sewer System Facility Requirements (Appendix A) for the flow depth, and slope requirements.

APPENDIX A

**AUGUST 2008 LEE LAKE WATER DISTRICT SEWER SYSTEM
FACILITY REQUIREMENTS**

Lee Lake Water District

Sewer System Facility Requirements

August 2008

Board Members:

***Charles Colladay - President
Joyce Deleo - Vice President
Owen Garrett - Secretary/Treasurer
Grant Destache - Board Director
Paul Rodriguez - Board Director***

General Manager:

Jeff Pape

**LEE LAKE WATER DISTRICT
SEWER SYSTEM FACILITY REQUIREMENTS
AUGUST 2008**

**LEE LAKE WATER DISTRICT
22646 TEMESCAL CANYON ROAD
CORONA, CALIFORNIA 92883
PHONE: (951) 277-1414
FAX: (951) 277-1419**

**LEE LAKE WATER DISTRICT
SEWER SYSTEM FACILITY REQUIREMENTS**

TABLE OF CONTENTS

	<u>PAGE</u>
SECTION I	INTRODUCTION I-1
	A. General..... I-1
	B. Requirements I-2
SECTION II	PROCEDURES - CONSTRUCTION DRAWING APPROVAL.....II-1
	A. Construction Drawings ApprovalII-1
SECTION III	DESIGN CRITERIA III-1
	A. Sewer System Analysis Criteria III-1
	B. Sewage Lift Stations and Metering Stations III-2
	C. Sewer Construction Drawing Design Criteria..... III-3
SECTION IV	CONSTRUCTION DRAWING PREPARATION IV-1
	A. General..... IV-1
	B. Cover Sheet IV-1
	C. Plan and Profile Sheets..... IV-3
	D. Grant of Easements IV-8
SECTION V	PROCEDURES - SEWER SYSTEM FACILITY CONSTRUCTION V-1

APPENDICES

APPENDIX A	FLOWCHART FOR CONSTRUCTION DRAWING APPROVAL
APPENDIX B	PLAN CHECK STATUS SHEET
APPENDIX C	REQUEST FOR SEWER SERVICES APPLICATION
APPENDIX D	GENERAL CONSTRUCTION NOTES
APPENDIX E	LEGEND AND ESTIMATE OF QUANTITIES
APPENDIX F	CONSTRUCTION APPROVAL BOX/SEWER SYSTEM CERTIFICATION
APPENDIX G	SEWER CONSTRUCTION DRAWINGS CHECKLIST
APPENDIX H	GRANT OF EASEMENT
APPENDIX I	FLOWCHART FOR CONSTRUCTION OF SEWER FACILITIES
APPENDIX J	CONSTRUCTION STATUS SHEET
APPENDIX K	CONTRACTOR INFORMATION SHEET
APPENDIX L	SEWER SYSTEM CONSTRUCTION AGREEMENT
APPENDIX M	CERTIFICATION OF STREETS TO FINAL GRADE
APPENDIX N	CERTIFICATE OF INSURANCE
APPENDIX O	FAITHFUL PERFORMANCE BOND
APPENDIX P	UNCONDITIONAL LIEN WAIVER AND RELEASE
APPENDIX Q	SEWER SYSTEM GRANT DEED
APPENDIX R	PEAK FLOW FACTORS

SECTION I

INTRODUCTION

A. GENERAL

The Lee Lake Water District was formed in 1965 as a California Water District in order to provide water and wastewater service to properties within the I-15 corridor north of Lake Elsinore and South of the City of Corona.

One of LLWD's responsibilities is the delivery of potable water to its customers. LLWD receives all of its water from Western Municipal Water District (WMWD) via WMWD's Mill's Pipeline which receives treated imported State Water Project water through the Mills Filtration Plant located on Allesandro Boulevard in Riverside.

The other responsibility of the District is to provide wastewater service through the collection, treatment, and disposal of sewage produced within the District boundary. Currently, the District operates one treatment facility called the Lee Lake Water Reclamation Facility (LLWRF) with a capacity of 1,580,000 gallons per day. The LLWRF is capable of producing reclaimed water suitable for landscape irrigation uses in compliance with Title 22 of the State Department of Health Services.

The District owns and operates many miles of water transmission and wastewater collection facilities within the District boundaries in order to convey water and wastewater to their respective endpoints.

B. REQUIREMENTS

1. Developer shall design, construct, and dedicate to Lee Lake Water District the sewage collection, pumping and transmission facilities in accordance with the requirements of Lee Lake Water District.
2. Developer shall provide all financial arrangements necessary to plan, design, and construct the project.
3. Developer shall obtain and dedicate sewer utility right-of-way to Lee Lake Water District. Sewer facilities must be in either dedicated road right-of-way or in easements granted to Lee Lake Water District.
4. Developer shall pay current applicable fees (refer to District's Rates and Charges) in addition to completing those requirements listed above. Fees may include; Plan Checking Fees, Connection Charges, Inspection Fees, Added Facilities Charges. District staff should be consulted for current and applicable fees.
5. Lee Lake Water District will review all drawings, and may revise, modify, or require redesign of any concepts, drawings, or details submitted. All concepts and drawings must be approved by the District Engineer.
6. The Developer shall pay for any corrosion engineering costs. These costs shall include a corrosion site survey and a cathodic protection design, if necessary.
7. Procedures for development of sewer systems are similar for Tract Map developments, Parcel Map developments, and single lot main extension

developments. Most procedures and design requirements herein have been prepared for Tract Map developments, but certain portions apply to all sewer system development work within Lee Lake Water District's service area.

SECTION II PROCEDURES CONSTRUCTION DRAWING APPROVAL

A. CONSTRUCTION DRAWINGS APPROVAL

District staff will review all sewer construction drawings and may revise, modify, or require redesign of any concepts, drawings, or details submitted. All concepts and drawings must be approved by the District Engineer. Construction must begin within one year of approval of Sewer Construction Drawings. If more than one year has elapsed, the project must go through plan check procedure again before starting construction. The steps required to obtain Sewer Facilities Construction Drawing approval are as follows:

1. Submit Engineering Service Application and Plan Check Deposit.
2. Submit Tract Sewer System and Sewer System Analysis.
3. Submit first plan check.
4. Submit subsequent plan checks.
5. Submit original Construction Drawings for approval.
6. Provide District with drawings.

A flowchart for Construction Drawing Approval is shown in Appendix "A". A plan check status sheet to be used by District staff is shown in Appendix "B". Each required step is discussed in detail below:

1. Submit Engineering Service Application and Plan Check Deposit: The Sewer Service Application (available from the District) shall be completed and filed with the Customer services staff. The plan check deposit shall be submitted with the completed application. A copy of the Sewer Service Application is shown in Appendix "C".
2. Submit Tract Sewer System and Sewer System Analysis: Approximately one week after receiving the completed sewer services application and the plan check deposit, District staff will provide contributing sewer flows at connections to the District's system. If the District has no data on existing contributing sewer flows, then District may direct developer to measure sewer flows at selected manholes. District staff may, in addition, provide design recommendations for the sewer system and may request analysis of impact of project on existing downstream sewer facilities.

For commercial and industrial developments, pretreatment may be required.

Based on contributing sewer flows and design recommendations provided by the District, Developer shall submit to the District the following:

- a. One copy of the County of Riverside Conditions of Approval.
- b. Two copies of a master plan of the Tract with the proposed sewer facilities superimposed on same. Said plan shall show sewer manholes, diameter

and slopes of sewers between manholes, and average daily flow for each reach of sewer between manholes.

- c. Two copies of the sewer system analysis of the proposed sewer system.

Details regarding sewer system analysis are included in Section III, Design Criteria.

District staff will review the Tract Sewer System and the sewer system analysis and return one set with comments to the Developer. Minor revisions may be incorporated in the first plan check submittal. If major revisions are required, the Tract Sewer System and sewer system analysis shall be resubmitted until approved by District staff.

3. Submit First Plan Check

1. After review and approval of Tract Sewer System and sewer system analysis, Developer shall submit the following for plancheck review and approval:

- a. Two copies of the sewer/water construction drawings.
- b. One copy of the street improvement drawings.
- c. One copy of the grading plan.
- d. One copy of the approved Tract Sewer System and sewer system analysis.
- e. Two copies of easement documents.
- f. One copy of Tract/Parcel Map.
- g. Copy of receipt showing submittal to County for plan check of facilities within public rights-of-way.

Construction Drawing plancheck submittals must be complete or they will be rejected. Each submittal shall include a transmittal listing all items submitted and referencing the District project number.

Details regarding sewer design criteria are included in Section III, Design Criteria. Details regarding preparation of construction drawings and easement documents are included in Section IV, Construction Drawing Preparation.

Water and sewer drawings should be combined and shown on the same drawing whenever possible.

The District will provide comments on one set of the sewer construction drawings and return same to Engineer for revisions. The goal of the District staff is to complete the first plan check within three weeks of receipt of submittal. Plan review time varies depending on the number of plans in the review process, size of project, complexity of plans, and completeness of drawings.

4. Submit Subsequent Plan Checks

For each subsequent plan check, Developer shall submit the following:

- a. Previous District plan check set.
- b. Two copies of revised sewer construction drawings.
- c. Two copies of easement documents.
- d. Any additional material requested.
- e. One copy of revised submittal showing County comments for facilities to be installed in public rights-of-way.

Submittals must be complete or they will be rejected. If drawings and easement documents are not yet satisfactory, District will make comments on one set of the drawings and easement documents and return same to Engineer for revisions. This procedure will be repeated as necessary until drawings and easement documents are complete. If Engineer does not return previous District redlined plan check sets, then plan check procedure will start from the beginning including payment of plan check deposit.

Each cycle of the subsequent plan check would normally be completed in approximately three weeks.

5. Submit Original Construction Drawings for Approval

After all plan checks are completed and the sewer construction drawings are acceptable to the District, the original drawings shall be submitted to the District for signature. Prior to District approval of the sewer construction drawings, Developer shall pay all remaining plan checking fees and submit:

- a. Previous District plan check set and one copy of revised sewer construction drawings.
- b. Copy of tentative tract/parcel map showing dedications of streets for road purposes and public utilities purposes,

and/or

- c. Executed Grant of Easement.

Easements shall have the following width:

Sewer Flowline	Easement
<u>Depth (ft)</u>	<u>Width (ft)</u>
All Depths	20

District reserves the right to review requirements on a case by case basis, but the above should be used for planning purposes.

6. Provide District with Drawings

When drawings have been fully approved by all agencies, the Developer shall provide the District with a clean set of photo mylars and three sets of bluelines for District's use.

SECTION III

DESIGN CRITERIA

Sewer systems for inclusion into the District's service area shall be designed in accordance with the District's Standard Specifications and Standard Drawings for Water and Sanitary Sewer Facilities, or latest revision, and the following criteria:

A. SEWER SYSTEM ANALYSIS CRITERIA

The District reserves the right to determine the criteria for each sewer system or subsystem based upon conditions that may exist for that particular location, anticipated level of development, planned use, or other criteria. In general, however, the sewer system shall be sized to handle the highest flow within the general area of the tract and shall conform to the following minimum standards:

1. Sewer Diameters: The minimum sewer main diameter is 8".
2. Sewer Friction Factors: The friction factor for gravity sewers (PVC and VCP) shall be $n = 0.013$. The friction factor for force mains (PVC) shall be $"C" = 120$.
3. Average Daily Flow: The residential flow factor shall be 100 gallons per capita per day and the number of people per dwelling unit shall be 2.6 people. Each Equivalent Dwelling Unit (EDU) is equal to 260 gallons per day. The commercial and industrial flow factor shall be 2,000 gallons per acre per day.
4. Peak Flows: Peak flow shall be computed from the average daily flow and the peaking factors shown in Appendix "R".
5. System Analysis: Each sewer in the proposed sewer system shall be analyzed for the following two conditions:
 - a. Average Daily Flow
 - b. Peak Wet Weather Flow

Gravity sewers shall be designed at peak flow with a minimum velocity of 2 feet per second and a maximum velocity of 8 feet per second. The ratio of depth of flow to sewer diameter at peak flow shall not exceed 0.50 for 10" sewer diameters, and smaller and 0.75 for sewer diameters 12" and larger.

Force mains shall be designed to maintain a velocity of between 3 and 5 feet per second. Head losses for force mains shall be approximately 5 feet per 1,000 feet of force main.

B. SEWAGE LIFT STATIONS AND METERING STATIONS

Design of sewage lift stations and metering stations may be performed by the District at Developer's expense. Otherwise, the District will review these stations on a case-by-case basis at the sole cost of the Developer.

C. SEWER CONSTRUCTION DRAWING DESIGN CRITERIA

1. Sewer Location: Unless otherwise approved by the District, all sewers shall be located on the north or east side of the street, six feet from the street centerline per the Riverside County Road Department standards. Location is not to interfere with other existing utilities.

Pipe joint deflection shall not be more than manufacturer's recommended offset in a curved alignment. Joint deflection angle shall be indicated on all horizontal and vertical curves.

Sewer installation near water lines shall be in accordance with State Department of Health Services, Criteria for the Separation of Water Mains and Sanitary Sewers. In general, sewers should cross perpendicular to water lines a minimum of one foot below the water. Sewer lines parallel to water lines shall be located a minimum of 10 feet (clear space) from the water line.

When crossing other utilities, provide a minimum of one foot vertical clearance.

2. Minimum Sewer Cover: The minimum cover over the top of sewer shall be 7 feet from finished road grade, unless at the end of a cul-de-sac where minimum shall be 4 feet. Adequate depth shall be provided so that the sewer laterals will have a minimum cover of five (5) feet at the property line with a minimum slope of 2% from the sewer to property line, unless at end of cul-de-sacs.

The minimum cover over the top of force mains shall be 42-inches from the finished road grade.

3. Sewer Materials: Unless otherwise authorized by District, all sewers shall be constructed of the following materials:

Residential Sewers: PVC (SDR 35) for depth of cover 15 feet or less,
 PVC (C900 or C905) for depth of cover over 15 feet.

or

VCP (extra strength or high strength)

Commercial/Industrial: PVC (C900 or C905), unless DIP required by District

Force Mains: up to 12-inch diameter - PVC (C900), Class 200 minimum (residential force main only)

All diameters greater than 12-inches - ductile iron pipe

4. Pipe Slope: Gravity sewers shall have the following minimum slope:

<u>Diameter (Inches)</u>	<u>Slope (ft / 100 ft)</u>
8	0.40
10	0.30
12	0.24
15	0.18
18	0.11
21	0.10
24	0.08
27	0.07
30	0.06
33	0.044
36	0.040
42	0.032

Minimum slope out of a cul-de-sac or where less than 10 EDUs are connected is 2%. Minimum slope where 10 to 40 EDUs are connected is 1%.

Minimum slope of forcemains shall be 0.5% unless otherwise authorized by District. Air valves shall be located at all high points of force mains. Minimum size of air valves shall be 1-inch and shall be sized per manufacturers recommendation.

Blowoffs shall be located at all low points of the forcemain. Minimum size of Blowoffs shall be 4-inches. Consult with District staff regarding size.

5. Manholes: Manholes shall be spaced at 300 foot maximum intervals and at all grade breaks, changes in horizontal alignment, changes in sewer diameter, and at the end of all sewers. Drop manholes are NOT allowed without special review and approval by the District Engineer.

Manhole rim elevations shall be lower than all pad elevations immediately down stream. If this condition cannot be met, then back flow prevention valve must be installed in accordance with the plumbing code (Section 409-a). A list of the affected lots shall be prepared by the Design Engineer and submitted to the contractor/developer/owner with a carbon copy to the District Engineer.

Drop of elevation through manholes shall be 0.10 foot. At right angle alignment or bend drop shall be 0.20 foot.

Pre-cast concrete manholes shall be used. Standard 4-foot structures with 2-foot frame and cover shall be called out on the plans where the depth of manhole measured from the flow line to the rim is less than 12-feet, and pipe diameters are less than or equal to 10-inches. Manholes shall be 5-feet in diameter with 3-foot frame and two piece cover under the following conditions;

- a. Depth of the structure from the top of pipe to the rim is equal to or greater than 12-feet.
- b. Sanitary sewer main diameter is 12-inch or greater.

Manhole Lining: For 1) all new manholes on sewers 15-inches or greater in diameter, 2) all new manholes where the entering pipe slope is 5% or greater, 3) all existing manholes with new connections, and 4) all manholes within 1,000 feet of receiving a force main discharge; the manholes shall be provided with Integrally Locking PVC or Polyurethane Protective Lining System per Section 500-2 of the Greenbook.

6. Sewer Laterals: Sewer laterals shall have a minimum diameter of 4" and shall be constructed of the same materials as the sewer. Lateral minimum size for commercial and industrial shall be 6-inch. Each building shall have a separate lateral. Laterals shall have a minimum slope of 2 % and shall have a minimum cover of 5' at the property line. Laterals shall be below the water main with a minimum clearance of 12-inches. Where clearances are critical, and laterals designed to clear the waterline, they shall be detailed on the plans. Laterals shall not enter a manhole. Laterals must have 10-foot separation from water service. Bends are not allowed in laterals without the approval of the District Engineer. Only when bends are approved, they shall be provided with cleanouts at each approved bend.

7. Sewer Curves:

- a. Curvilinear alignments for sanitary sewers shall be specifically requested by the Engineer associated with the project. The request shall include all data (calculations and preliminary plan layouts) needed to evaluate the design of the sewer system.
- b. All curvilinear sanitary sewers shall be designed within the street right-of-way and concentric with the radius of horizontal curves. In no case shall horizontal curvilinear alignments be allowed outside dedicated street right-of-ways. Poor construction techniques resulting in deflection of a straight sewer shall not be accepted as a curvilinear sewer.
- c. Both horizontal and vertical curvilinear sewers may be used. However, vertical curves shall not be permitted in the same reach with horizontal curves.

Curvilinear alignments shall not be permitted in sanitary sewers carrying commercial and industrial wastes, except with the specific approval of the District Engineer.

- e. The use of curvilinear alignments shall be prohibited in areas of potential root growth except with the specific approval of the District Engineer.

- f. Manholes shall be required for all changes in direction, both horizontal and vertical, and for all changes in the radius of curvature.
 - g. The minimum radius of curvature for VCP shall be 200', providing that the deflection shall not exceed ASTM C-425. The minimum radius of curvature for PVC shall be 280'.
 - h. All bedding material shall be sand (sand equivalency = 30) unless otherwise required or approved by the District Engineer and comply with Lee Lake Water District Standard Drawing, S-1.
 - i. Inspection of all curvilinear sewers shall be requested a minimum of seven (7) days before the start of construction.
 - j. All reaches containing curvilinear alignments shall be televised after all other testing of the sanitary sewers is complete. Televising shall include a visual identification of each reach and a continuous display of the distance from the entry manhole. All video equipment needed to review the televised sewer shall be furnished by the developer. Alternatively, the District may contract for the televising of curved sewers and require the developer to bear all costs incurred.
8. Easement Criteria: Sewers not located within public right-of-way must be located in easements granted to the District on the District's Grant of Easement form. Easements shall be a minimum of 20-feet in width unless otherwise specified (see Section II, 5c). Details for grant of easement documents are included in Section IV, Construction Drawing Preparation.

SECTION IV

CONSTRUCTION DRAWING PREPARATION

A. GENERAL

Engineer shall prepare sewer system improvement drawings that are clear, concise, and meet District standards.

Drawings shall be plotted on D size mylar sheets (24" x 36") with Lee Lake Water District approval block.

The drawings shall be professional quality drawings especially prepared as SEWER DRAWINGS or WATER AND SEWER DRAWINGS. Work shall be of standard engineering practice and shall be legible and present the proposed construction without confusion. The drawings shall be signed by a California Registered Civil Engineer.

Water and sewer design may be shown on the same drawings if the drawings are clear and concise. The District shall be the sole judge as to when separate drawings are necessary.

B. COVER SHEET

The cover sheet shall show as a minimum:

1. General notes (Appendix "D")
2. Legend (Appendix "E")
3. Estimate of quantities (Appendix "E")
4. Approval for Construction Box (Appendix "F")
5. Sewer System Certification (Appendix "F")
6. Index of Drawings
7. Vicinity Map
 - a. Scale
 - b. North Arrow
 - c. Street Names
 - d. Title and Location of Project
8. Index Map
 - a. Scale
 - b. North Arrow
 - c. Tract Layout with Street Names and Lot Numbers
 - d. Proposed Sewers Identified by Size and Type
 - e. Symbols for all Appurtenances
 - l. Manholes

2. Sewer Laterals
3. Clean-outs
4. Valves, Air Valves, and Blowoffs for Forcemains
- f. Sheet Numbers Corresponding to Plan and Profile Sheets

The use of a second sheet to include all information is permissible.

C. PLAN AND PROFILE SHEETS

The plan/profile sheets shall be drawn at a horizontal scale of 1" = 40' and a vertical scale of 1" = 4', and as a minimum the drawings shall show the following:

PLAN PORTION

1. Title Block: Title block shall show Tract No. and scale of drawings. District approval blocks shall be incorporated into the title block.
2. North Arrow: North arrow shall point up or to the left if possible to conform with Item 11.
3. Right-of-Way: Existing and proposed right-of-way shall be identified with dimensions for same shown.
4. Curb Separation: Existing and/or proposed curb separation shall be identified with dimensions for same shown.
5. Easements: Existing or proposed easements shall be identified with dimensions for same shown.
6. Street Names: All street names shall be shown.
7. Lot Lines: All lot lines and parcel lines shall be shown. All lots shall be numbered or labeled. All adjacent tracts shall be identified.
8. Utilities: All existing and proposed Utilities shall be shown. Utilities to be shown shall include, but not be limited to, sewer (existing sewers shall be identified by District Plan No.), water, gas, power, telephone, storm drain, irrigation, traffic, and cable television. Each utility shall be identified with a symbol and the size of the utility shall be shown.
9. Existing and Proposed Improvements: All existing surface improvements shall be shown including, but not limited to, curb and gutter, edge of pavement, power poles, driveways, sidewalks, and fences.
10. Match Lines: Match lines for each end of the street shall be shown as follows:
 Sta 15+00.00 Match Line
 See Sheet 5
11. Stationing: Stationing along the centerline of the improvement shall be shown. Only stationing along centerline of improvement (right-of-way) may be used unless otherwise allowed by District Engineer. Unless otherwise specified,

station shall increase from left to right and uphill. Stationing shall be identified with tick marks at 100 foot intervals.

12. Proposed Sewer: Proposed sewer shall be indicated with a heavy line. Dimensions from street centerline to centerline of pipeline shall be shown. Pipeline shall be identified as:

_____ " VCP (High strength or Extra Strength) Sewer

OR

_____ "PVC (SDR 35) Sewer

OR

_____ "PVC C900 DR18 Sewer

OR

_____ "PVC C905 DR18 Sewer

OR

_____ "PVC C900 Class _____ Force Main

13. Appurtenances: All sewer appurtenances including manholes and clean-outs shall be identified by station and Lee Lake Water District Standard Number as follows:

Sta 12+25.00 Manhole No. 1 per LLWD Std. Dwg. No.

All sewer laterals shall be indicated on the drawings. The stationing of laterals is not required on the drawings, however, after construction of proposed facilities, the engineer shall provide the District with an "as-built" stationing table of the laterals on the record drawings.

All connections to existing sewer system shall be identified by station and size. A station equation and District plan number shall be used to reference existing sewers. Details for connections shall be used where required.

PROFILE PORTION

Only profiles for water and sewer shall be shown. All other utility profiles shall not be shown unless conflicting or where crossing over or under (i.e. storm drain).

1. Stationing: Stations shall be shown along bottom of profile at 100 foot intervals. Profile stationing shall line up with plan stationing.
2. Elevations: Elevations shall be shown on both ends of the profile sheet.
3. Existing and Proposed Ground Surface: Existing ground surface or pavement over the proposed sewer shall be identified as follows:

"Existing Top of Pavement (or ground surface) over Centerline of Sewer"

Copies of Grant of Easement form and plat are shown in Appendix "H". Items to be included on the plat map are shown in said appendix.

SECTION V
PROCEDURES
SEWER SYSTEM
FACILITY CONSTRUCTION

All sewer facility projects will be constructed by Developer and inspected by District inspectors. Work performed without the knowledge or the observation of a District inspector will not be accepted. The steps required to obtain approval of construction of sewer facilities are as follows:

1. Submit Customer Service Application and Inspection Deposit.
2. Provide Submittals, Sewer System Construction Agreement, Bonds, and Certificate of Insurance.
3. Attend Preconstruction Meeting.
4. Notify District Regarding Construction Start.
5. Construct Sewer System Facilities.
- b. Pressure Test Sewer System Facilities.
7. Pay any Remaining Fees and Charges.
8. Provide Unconditional Lien Waiver and Release, Sewer System Grant Deed, and Record Drawings.
9. Notice of Completion Filed by District.
10. Connect to Existing Sewer System.

A flowchart for sewer system facility construction is shown as Exhibit "I". A construction status sheet to be used by District is shown in Appendix "J". Each required step is discussed in detail below:

1. Submit Sewer Service Application and Inspection Deposit: The sewer service application (available from the District) shall be completed and filed with the District staff. A copy of the sewer services application is shown in Appendix "C". The inspection deposit and three copies of approved sewer construction drawings shall be submitted with the completed application.
2. Construction Submittals:
 - a. Developer/Contractor shall provide three copies of proposed materials for completion of the project (see Approved Materials List within the Lee Lake Water District Standard Drawings).
 - b. District Engineer reviews submittals and returns submittal with redline corrections, if necessary, to Developer/Contractor.

- c. Submittal process shall be repeated as necessary until all materials are approved by District Engineer.
- 2. Provide Sewer System Construction Agreement, Bonds and Certificate of Insurance: Developer shall submit to District staff the following:
 - a. Contractor information sheet (Appendix "K").
 - b. Two copies of Encroachment Permits.
 - c. One copy of recorded tract/parcel map showing dedication of streets for road and public utility purposes (not required if executed Grant of Easement provided earlier).

After District executes Sewer System Construction Agreement (Appendix "L"), approves Contractor, and approves materials list, Developer shall submit the following:

- a. Copy of the Contract between Developer and Contractor verifying cost of sewer system facility construction.
- b. Certification of streets to final grade (Appendix "M").
- c. Certificates of Insurance for Contractor (Appendix "N").
- d. Faithful Performance Bond (Appendix "O"). Performance bonds provided to the City/County are satisfactory if the facilities to be turned over to the District are included.

After District reviews and approves all submittals, District staff will issue a Notice to Proceed.

Thereafter, Developer shall schedule a preconstruction meeting with District staff. A one week notice is required prior to said preconstruction meeting.

- 3. Attend Construction Meeting: Preconstruction meeting shall be held at the District office and shall be attended by Developer's representative, Developer's contractor, and construction superintendent as well as by District staff.
- 4. Notify District Regarding Construction Start: Contractor shall notify District, in writing, a minimum of 1 week prior to construction start. Prior to construction, Contractor shall submit three copies of the construction cut sheets for Districts use during construction. Sewers shall be staked at 25 foot intervals and at all sewer laterals, manholes, cleanouts, and grade breaks.
- 5. Construct Sewer System Facilities: The sewer system facilities shall be constructed by Developer's contractor and inspected by District inspectors. After completion of construction, Developer's contractor shall complete all items on District's inspection list prior to testing sewer facilities.


6. Test Sewer System Facility: After sewer facilities are completed to satisfaction of District inspector including all items on inspector's construction deficiencies list, and after Contractor furnishes evidence that compaction of trenches has been completed to the satisfaction of the County of Riverside Road Department, Contractor shall test the sewer facility in accordance with District Standards.
7. Pay Any Remaining Fees and Charges: Any remaining fees and charges must be paid in full.
8. Provide Unconditional Lien Waiver and Release Sewer System Grant Deed and Record Drawing

Before District will allow removal of sewer plugs, Contractor shall:

 - a. Provide Unconditional Lien Waiver and Release for sewer construction (Appendix "P").
 - b. Provide Grant Deed dedicating sewer system to District. Said Grant Deed is effective only after final Notice of Completion for sewer system facilities is filed by District staff. Grant Deed must be filed on form provided by District (Appendix "Q").
 - c. Provide Sewer system record ("As-Builts") drawings.
9. Notice of Completion Filed District: After receipt, and approval of items in Section 8, District will file Notice of Completion.
10. Connect to Existing Sewer System: After Notice of Completion has been filed by District, District will notify Contractor that he may connect sewer facilities to existing sewer facility system by removing sewer plugs.

APPENDIX A
FLOWCHART FOR CONSTRUCTION
DRAWING APPROVAL

FLOWCHART FOR CONSTRUCTION DRAWING APPROVAL

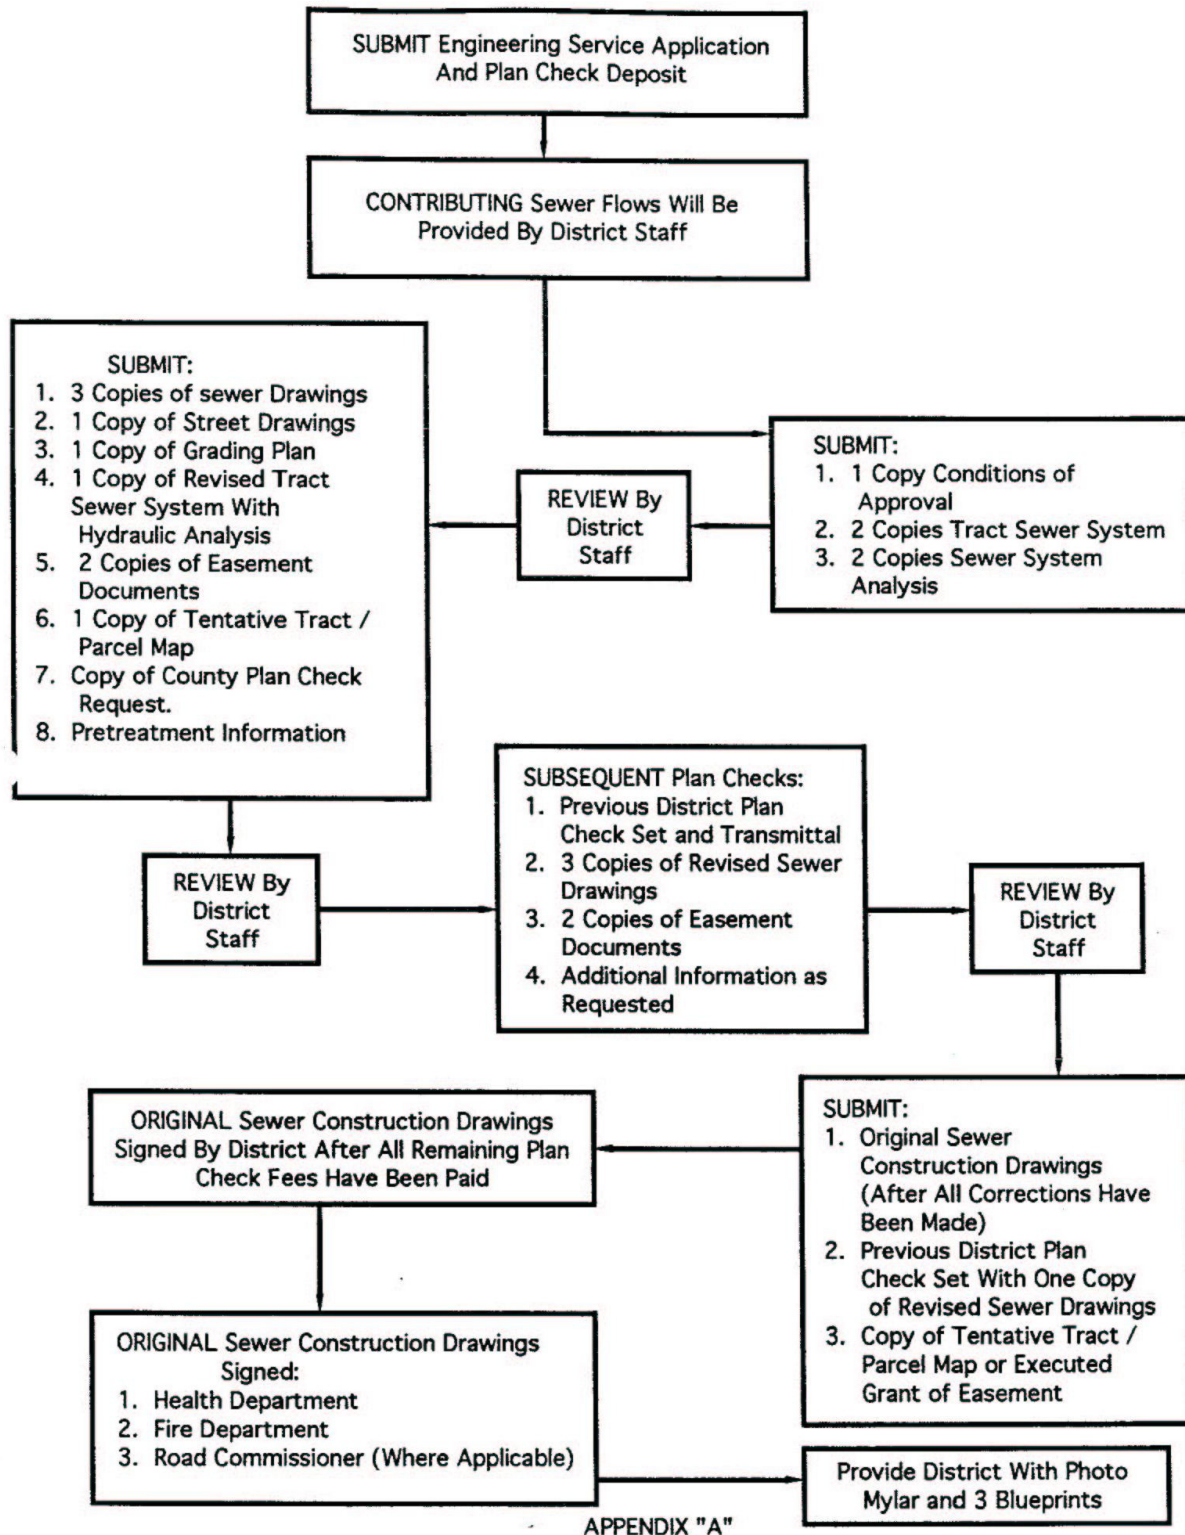

APPENDIX B
PLAN CHECK STATUS SHEET

**LEE LAKE WATER DISTRICT SEWER
SYSTEM FACILITY REQUIREMENTS**

PLAN CHECK STATUS SHEET

LLWD JOB NO. _____

TRACT NO. _____

PARCEL MAP NO. _____

NAME OF PROJECT: _____

DEVELOPER: _____

LOCATION OF PROJECT: _____

ENGINEER: _____

PHONE: _____

	ITEM	DATE	INITIAL
1.	Received Engineering Service Application and Plan Check Deposit (Engineer)	_____	_____
2.	Provide Contributing Sewer Flows (District)	_____	_____
3.	Received:		
	- Pretreatment Information	_____	_____
	- One Copy of Conditions of Approval (Engineer)	_____	_____
	- Two Copies of Tract Map with Proposed Sewer System Including Manholes (Engineer)	_____	_____
	- Two Copies of Sewer System Analysis of Proposed System (Engineer)	_____	_____
4.	Review Item 3 and Provide Comments (District)	_____	_____
5.	Received First Plan Check (Engineer):		
	- Three Copies of Sewer/Water Construction Drawings	_____	_____
	- One Copy of Street Improvement Drawings	_____	_____
	- One Copy of Grading Plan	_____	_____
	- One Copy of Revised Tract Map with Sewer System Analysis	_____	_____
	- Two Copies of Easement Documents	_____	_____
	- One Copy of Tract/Parcel Map	_____	_____
	- Copy of City/County Plan Check Receipt	_____	_____
6.	Review First Plan Check, Provide Comments (District)	_____	_____
7.	Received Second Plan Check (Engineer):		
	- Previous District Plan Check Set and Transmittal	_____	_____
	- Three Copies of Revised Sewer Construction Drawings .	_____	_____
	- Two Copies of Easement Documents	_____	_____
	- Copies of Additional Information as Requested	_____	_____

- | | | | |
|-----|--|-------|-------|
| 8. | Review Second Plan Check, Provide Comments (District): | _____ | _____ |
| 9. | Received Third Plan Check (Engineer): | | |
| | - Previous District Plan Check Set and Transmittal | _____ | _____ |
| | - Three Copies of Revised Sewer Construction Drawings | _____ | _____ |
| | - Two Copies of Easement Documents | _____ | _____ |
| | - Copies of Additional Information as Requested | _____ | _____ |
| 10. | Review Third Plan Check, Provide Comments (District) | _____ | _____ |
| 11. | Received Original Construction Drawings for Signature (Engineer) | _____ | _____ |
| | - Previous District Plan Check Set and One Copy of Revised Sewer Construction Drawings | _____ | _____ |
| | - All Remaining Plan Check Fees Paid | _____ | _____ |
| | - Copy of Tentative Tract/Parcel Map | _____ | _____ |
| | or | | |
| | - Executed Grant of Easement | | |
| 12. | Construction Drawings Signed (District) | | |
| 13. | Received One Set of Photo Mylars and Three Sets of Construction Drawings (Engineer) | _____ | _____ |

APPENDIX C
REQUEST FOR SEWER SERVICES APPLICATION

LEE LAKE WATER DISTRICT
Request for Sewer Services Application

Work Order # _____

Applicant's Name and Address:

Name	
Street Address	Telephone ()
City	State

Owner/Responsible Party Name and Mailing Address:

Name	
Street address	Telephone
City	State

Services Required:

<input type="checkbox"/> Sewer Service	<input type="checkbox"/> Street	<input type="checkbox"/> Easement	<input type="checkbox"/> New Lateral	<input type="checkbox"/> Exist. Lateral	<input type="checkbox"/> Main Line extension
<input type="checkbox"/> Residential <input type="checkbox"/> Commercial <input type="checkbox"/> Size: (Circle one) 4" 6" 8"					
<input type="checkbox"/> Plan Check			<input type="checkbox"/> Inspection of Pipeline		
<input type="checkbox"/> Feasibility Study	<input type="checkbox"/> Pipeline Extension	<input type="checkbox"/> Will Serve (Sewer Availability)	<input type="checkbox"/> Other		

Location Where Services are Required:

APN	Street #/Name
Depth of Lateral	Location of Lateral
Other Location Information	

Calculation of Costs:

Sewer Service Fees:				
Reimbursement Agreements				\$
Other				\$
Plan Check Deposit:	\$	Processing Fee + \$	1 st 1,000 Ft. + \$	addit'l footage \$
Inspection Deposit:	\$	Processing Fee + \$	1 st 1,000 Ft. + \$	addit'l footage \$
Other Fees:	Temporary Service Agreement			\$
Annexation				\$
Other:				\$
				\$
				\$
				\$
Cust. Acct. Type		Cust. Act. No.	TOTAL DUE:	\$
Total Received \$		Check #		

CUSTOMER RECEIPT

APPENDIX "C"

APPENDIX D
GENERAL CONSTRUCTION NOTES

**LEE LAKE WATER DISTRICT
GENERAL CONSTRUCTION NOTES**

1. CONSTRUCTION NOTES

- A. CONTRACTOR SHALL FURNISH AND INSTALL ALL FACILITIES IN ACCORDANCE WITH LEE LAKE WATER DISTRICT (LLWD) WATER SYSTEM FACILITY REQUIREMENTS, STANDARD SPECIFICATIONS AND STANDARD DRAWINGS. LLWD STANDARD SPECIFICATIONS AND STANDARD DRAWINGS ARE AVAILABLE AT THE DISTRICT OFFICE. CONTRACTOR SHALL BE IN POSSESSION OF DISTRICT'S SPECIFICATIONS AND STANDARD DRAWINGS ON THE JOB SITE AT ALL TIMES.
- B. ALL PERMITS REQUIRED BY LAW SHALL BE ACQUIRED BY THE APPLICANT OR THEIR CONTRACTOR AND ARE MADE PART OF THE SPECIFICATIONS.
- C. THE DRAWINGS AND DATA HEREON ARE HEREBY MADE PART OF THE SPECIFICATIONS.
- D. REVISIONS WILL NOT BE MADE TO THESE PLANS WITHOUT THE APPROVAL OF LLWD.
- E. APPROVAL OF THESE PLANS BY LLWD DOES NOT CONSTITUTE A REPRESENTATION OF THE ACCURACY OF THE LOCATION OR EXISTENCE OR NON-EXISTENCE OF ANY UNDERGROUND UTILITY, PIPE OR STRUCTURE WITHIN THE LIMITS OF WORK.
- F. CONTRACTOR SHALL NOTIFY THE LLWD ONE WEEK PRIOR TO STARTING CONSTRUCTION.
- G. THE LLWD INSPECTOR SHALL BE FURNISHED THREE SETS OF PROJECT DRAWINGS.
- H. THE CONTRACTOR SHALL CONFORM TO CURRENT CAL OSHA SAFETY REQUIREMENTS.
- I. THE CONTRACTOR SHALL SUBMIT TO THE LLWD A SOILS REPORT BY A QUALIFIED GEOTECHNICAL ENGINEER WHICH CERTIFIES THAT ALL TRENCH BACKFILL WAS COMPACTED AS DIRECTED BY THE SOILS ENGINEER IN ACCORDANCE WITH PROJECT SPECIFICATIONS AND LLWD SPECIFICATIONS.
- J. EACH LOT SHALL BE SERVICED WITH A FOUR (4)-INCH SEWER LATERAL SET AT A MINIMUM GRADE OF 2.0% WITH A MINIMUM INVERT DEPTH OF 5.0 FEET BELOW THE BOTTOM OF THE CURB AT THE PROPERTY LINE, UNLESS OTHERWISE APPROVED BY THE LLWD.

- K. ALL LATERALS SHALL BE LOCATED AS SHOWN ON THE DRAWINGS, ADJUSTED UNDER LLWD INSPECTION TO CLEAR DRIVEWAYS AND OTHER IMPROVEMENTS. LATERALS SHALL BE FOUR (4)-INCH MINIMUM DIAMETER UNLESS OTHERWISE NOTED ON THE DRAWINGS. ALL LATERALS SHALL HAVE A CLEAN OUT IN ACCORDANCE WITH STANDARD DRAWINGS NO. S-9 AND S-30. LATERALS SHALL BE INSTALLED IN ACCORDANCE WITH LLWD STANDARD DRAWING NOS. S-4, S-5, S-6, AND S-7.
- L. JOB-MIXING OF CONCRETE IS NOT PERMITTED.
- M. ALL CONCRETE TESTING REQUIRED BY THE LLWD WILL BE AT THE EXPENSE OF THE CONTRACTOR.
- N. THE CONTRACTOR SHALL SECURE APPROVAL FROM THE LLWD INSPECTOR PRIOR TO BACKFILLING OVER ANY SEWER PIPE OR WYE.
- O. ALL SEWER LATERALS AND MAINS SHALL BE TESTED BY "AIR TEST METHOD" AFTER CONSTRUCTION AS SPECIFIED BY THE LLWD SPECIFICATIONS.
- P. ALL ACCESS HOLES (MAN HOLES) SHALL BE TESTED BY "VACUUM TESTS" AS SPECIFIED IN THE LLWD STANDARD SPECIFICATIONS.
- Q. CONTRACTOR SHALL PROVIDE WRITTEN NOTIFICATION REQUESTING A SYSTEM SHUTDOWN FOR CONNECTIONS TO EXISTING SYSTEM. SAID NOTIFICATION SHALL BE OF THREE WEEKS PRIOR TO SAID SHUTDOWN TO THE LLWD DISTRICT ENGINEER.
- R. CONTRACTOR SHALL DESIGNATE A QUALIFIED SUPERINTENDENT WITH FULL AUTHORITY TO ACT ON BEHALF OF THE CONTRACTOR. SAID SUPERINTENDENT SHALL BE ON THE JOB SITE AT ALL TIMES.
- S. CONTRACTOR SHALL PERFORM ALL WORK UNDER RIVERSIDE COUNTY ROAD DEPARTMENT JURISDICTION IN ACCORDANCE WITH ALL REQUIREMENTS OF SAID DEPARTMENT INCLUDING TRAFFIC CONTROL, PAVEMENT REMOVAL, TEMPORARY PAVEMENT (INCLUDING BASE MATERIAL) AND TEMPORARY AND PERMANENT TRAFFIC STRIPPING.
- T. ALL MATERIALS, TESTING, AND INSPECTION OF THE SEWER SHALL BE IN CONFORMITY WITH THE REQUIREMENTS OF LLWD AND RIVERSIDE COUNTY STANDARDS. FAILURE TO MEET ANY REQUIREMENTS OF THE ABOVE REFERENCED AGENCIES WILL BE CAUSE FOR REJECTION.
- U. SEWER SHALL BE ____-INCH PVC (SDR 35) OR ____-INCH PVC C900 OR C905 (REQUIRED FOR SEWER DEPTH>15-FEET) IN ACCORDANCE WITH LLWD SPECIFICATIONS AND STANDARDS.
- V. FORCE MAINS SHALL BE ____-INCH PVC IN ACCORDANCE WITH LLWD SPECIFICATIONS AND STANDARDS (PROVIDE FORCE MAIN DIAMETER, C900 OR C905, AND PIPE CLASS 200 OR GREATER).

- W. STANDARD MANHOLES SHALL BE CONSTRUCTED IN ACCORDANCE WITH LLWD STANDARD DRAWING NO. S-12. TERMINUS TYPE MANHOLES SHALL BE CONSTRUCTED IN ACCORDANCE WITH LLWD STANDARD DRAWING NO. S-13.
- X. STANDARD MANHOLE COVERS SHALL BE CONSTRUCTED IN ACCORDANCE WITH LLWD STANDARD DRAWING NO. S-14 AND S-15. IN UNPAVED AREAS LOCKING TYPE MANHOLE COVERS SHALL BE CONSTRUCTED IN ACCORDANCE WITH LLWD STANDARD DRAWING NO. S-17.
- Y. SEWER BEDDING, BACKFILL, CAPS, AND ENCASEMENT, CAPS SHALL BE IN ACCORDANCE WITH LLWD STANDARD DRAWING NO. S-1, S-2, AND S-3.
- Z. CONTRACTOR SHALL PROVIDE AND BEAR THE TOTAL COST OF CLOSED CIRCUIT VIDEO INSPECTION OF ALL NEW INSTALLED PIPELINES UNLESS OTHERWISE DIRECTED BY THE DISTRICT INSPECTOR.
- AA. PRIOR TO POURING OF MANHOLE BASE, CONTRACTOR SHALL INSTALL A MANHOLE ADAPTER MADE BY GPK PRODUCTS, INC FOR ALL INLET(S) AND OUTLET AT THE PROPER GRADE AND DIRECTION.
- BB. EACH MANHOLE SHALL BE VACUUM TESTED IMMEDIATELY AFTER ASSEMBLY AND PRIOR TO BACKFILLING BY THE CONTRACTOR. AFTER THE CONTRACTOR COMPLETES BACKFILLING AND PRIOR TO ACCEPTANCE BY THE DISTRICT, EACH MANHOLE SHALL BE RE-TESTED IN THE PRESENCE OF THE DISTRICT INSPECTOR.
- CC. NO GROUT SHALL BE PLACED IN THE HORIZONTAL JOINTS BEFORE TESTING.
- DD. A VACUUM OF 10 INCHES OF MERCURY SHALL BE DRAWN AND THE PUMP SHUT OFF. WITH ALL VALVES CLOSED, THE MANHOLE SHALL HOLD 10 INCHES OF MERCURY FOR 60 SECONDS.
- EE. IF THE MANHOLE FAILS THE INITIAL TEST, NECESSARY REPAIRS SHALL BE MADE WITH A NON-SHRINK GROUT TO THE OUTSIDE WHILE THE VACUUM IS STILL BEING DRAWN. RETESTING SHALL PROCEED UNTIL A SATISFACTORY TEST IS OBTAINED.
- FF. MANHOLE DIAMETERS SHALL BE 48-INCH FOR SEWER DIAMETER 24-INCH AND SMALLER, AND 60-INCH FOR SEWER PIPE DIAMETER 27-INCH AND LARGER AND FOR ALL MANHOLES WITH A DEPTH OF 12-FEET OR MORE. 36-INCH CONE SHALL BE USED WITH A 60-INCH MANHOLE.
- GG. FOR 1) ALL NEW MANHOLES ON SEWER DIAMETERS 15-INCHES OR GREATER 2) ALL NEW MANHOLES WHERE UPSTREAM SEWER SLOPE IS 5% OR GREATER 3) ALL MANHOLES WITHIN 1000 FEET OF A FORCEMAIN DISCHARGE AND 4) EXISTING MANHOLES WITH NEW CONNECTIONS SHALL BE PROVIDED WITH INTEGRALLY LOCKING PVC OR POLYURETHANE PROTECTIVE LINING SYSTEM PER SECTION 500-2 OF THE GREENBOOK.

2. UTILITIES

- A. AT LEAST 48 HOURS BEFORE COMMENCING ANY EXCAVATION, CONTRACTOR SHALL REQUEST UNDERGROUND SERVICE ALERT (1-800-422-4133) AND NON-MEMBER COMPANIES, OR UTILITIES TO MARK OR OTHERWISE INDICATE THE LOCATION(S) OF THEIR SUBSURFACE FACILITIES INCLUDING, BUT NOT LIMITED TO, STRUCTURES INCLUDING VAULTS, MAIN CONDUCTORS OR CONDUITS, AND SERVICE CONNECTIONS.
- B. PRIOR TO CONSTRUCTION, CONTRACTOR SHALL EXPOSE EXISTING FACILITIES AT PROPOSED CONNECTIONS AND CROSSINGS AND VERIFY ELEVATIONS, LOCATIONS, AND SIZE OF EXISTING FACILITIES.
- C. CONTRACTOR SHALL NOT INTERRUPT OR DISTURB ANY UTILITY FACILITY WITHOUT AUTHORITY FROM THE UTILITY. WHERE PROTECTION IS REQUIRED TO ENSURE INTEGRITY OF UTILITY FACILITIES (INCLUDING DISTRICT-OWNED UTILITIES). CONTRACTOR SHALL FURNISH AND PLACE ALL NECESSARY PROTECTION.
- D. WHENEVER A WATERLINE ENCOUNTERS A STORM DRAIN PIPE OR OTHER OBSTRUCTION AND CROSSING OVER THE OBSTRUCTION WILL RESULT IN LESS THAN 42 INCHES OF COVER OVER THE TOP OF THE WATER, THE WATERLINE SHALL CROSS UNDER THE OBSTRUCTION WITH A MINIMUM CLEARANCE OF 12 INCHES.

3. CONSTRUCTION DRAWINGS

- A. MINIMUM FORCE MAIN COVER SHALL BE 42 INCHES FROM FINISHED GROUND SURFACE. MINIMUM SEWER COVER SHALL BE 7 FEET FROM FINISHED GROUND SURFACE.
- B. SEWER FORCE MAIN PROFILE ELEVATIONS ARE TO FLOW LINE OF SEWER FORCE MAIN. SEWER MAIN PROFILE ELEVATIONS ARE TO INVERT ELEVATION OF SEWER MAIN.
- C. STATIONING FOR SEWER AND FORCE MAIN AS SHOWN ON PLAN PORTION OF DRAWINGS IS PERPENDICULAR TO CENTERLINE OF RIGHT-OF-WAY.
- D. SEPARATION BETWEEN SEWER AND WATER SHALL CONFORM TO RIVERSIDE COUNTY STANDARD NO. 817 AND LLWD STANDARD DRAWING S-23 AND LLW-33.

5. CONSTRUCTION TOLERANCES

SEWERS SHALL BE CONSTRUCTED SO THAT ACTUAL FLOW LINE ELEVATIONS ARE WITHIN 0.02 FOOT OF DESIGN FLOW LINE ELEVATIONS. FORCE MAINS SHALL BE CONSTRUCTED SO THAT ACTUAL FLOW LINE ELEVATIONS ARE WITHIN 0.1 FOOT OF DESIGN FLOW ELEVATIONS. SEWERS,

WHEN INSTALLED, SHALL HAVE CONTINUOUS DOWN SLOPE. FORCE MAINS, WHEN INSTALLED, SHALL HAVE CONTINUOUS UPGRADE OR DOWNGRADE, CORRESPONDING WITH DESIGN SLOPE, WITHOUT ANY HIGH SPOTS. FORCE MAINS SHALL BE CONSTRUCTED SO THAT ACTUAL PIPELINE CENTERLINES ARE WITHIN 0.1 FOOT OF DESIGN PIPELINE CENTERLINES.

SEWER AND FORCE MAIN CONSTRUCTION SHALL CONFORM WITH CONSTRUCTION DRAWINGS IN ACCORDANCE WITH THE ABOVE SPECIFIED TOLERANCES. CONTRACTOR SHALL ASSIST DISTRICT AS REQUIRED TO CONFIRM COMPLIANCE WITH CONSTRUCTION TOLERANCES. CONTRACTOR SHALL MAKE OR ASSIST IN MAKING ALL NECESSARY MEASUREMENTS AS DETERMINED BY DISTRICT.

6. INSPECTION FEE

THREE WEEKS PRIOR TO CONSTRUCTION, A DEPOSIT FOR INSPECTION FEE WILL BE MADE. THIS FEE IS ESTIMATED AT \$. SHOULD ACTUAL COSTS BE GREATER, THE BALANCE SHALL BE PAID TO THE DISTRICT BY THE APPLICANT. SHOULD ACTUAL COSTS BE LESS, THE BALANCE SHALL BE REFUNDED TO THE APPLICANT. FEES SUBJECT TO CHANGE WITHOUT NOTICE.

7. ENGINEERING FIRM

PRIOR TO SIGNING OF SEWER CONSTRUCTION DRAWINGS BY LLWD, ALL QUESTIONS CONCERNING THIS PROJECT SHALL BE DIRECTED TO:

(NAME)

(TITLE)

(FIRM)

APPENDIX E
LEGEND AND ESTIMATE OF QUANTITIES

LEGEND AND ESTIMATE OF QUANTITIES

1. The Legend and Estimate of Quantities shall be included on the same sheet as the Index Map, in the following format.

<u>Quantity</u>	<u>Unit</u>	<u>Description</u>	<u>Standard Drawing Reference</u>
200	L.F.	8" PVC (SDR 35) Sewer Pipe	per S-1, & S-2

2. A separate entry is required for each size and type of all materials necessary for this project.

APPENDIX F

CONSTRUCTION APPROVAL BOX/ SEWER SYSTEM CERTIFICATION

LEE LAKE WATER DISTRICT

APPROVED FOR CONSTRUCTION:

General Manager

Date

Engineering

R.C.E.

DATE

WATER SYSTEM CERTIFICATION

I CERTIFY THAT THE DESIGN OF THE WATER SYSTEM IN _____ * _____ IS IN ACCORDANCE WITH THE WATER SYSTEM MASTER PLAN OF LEE LAKE WATER DISTRICT AND THAT THE WATER SERVICE, STORAGE AND DISTRIBUTION SYSTEM WILL BE ADEQUATE TO SUPPLY WATER TO SAID PROJECT. THIS CERTIFICATE DOES NOT CONSTITUTE A GUARANTEE THAT IT WILL SUPPLY WATER TO SAID PROJECT AT ANY SPECIFIC QUANTITIES, FLOWS, OR PRESSURE FOR FIRE PROTECTION OR ANY OTHER PURPOSE.

General Manager

Date

SEWER SYSTEM CERTIFICATION

I CERTIFY THAT THE DESIGN OF THE SEWER SYSTEM IN _____ * _____ IS IN ACCORDANCE WITH THE SEWER SYSTEM REQUIREMENTS OF LEE LAKE WATER DISTRICT AND THAT THE DISTRICT HAS PROGRAMMED ADEQUATE CAPACITY TO TREAT THE WASTES FROM THE PROPOSED PROJECT.

General Manager

Date

* WATER AND SEWER SYSTEM CERTIFICATION BLOCK TO BE COMPLETED BY THE ENGINEER OF RECORD SPECIFIC TO THE PROJECT.

IMPROVEMENT PLAN SIGNATURE BLOCKS AND CERTIFICATIONS

Sign_Blocks.dwg

1/27/2006 4:21:19 PM L:\Agency Standards\Lee Lake Water District\Sign_Blocks

APPENDIX G
SEWER CONSTRUCTION DRAWINGS CHECKLIST

LEE LAKE WATER DISTRICT

SEWER CONSTRUCTION DRAWINGS CHECKLIST

TRACT NO. _____ LLWD W.O. _____

COVER SHEET

VICINITY MAP		
Scale _____		
North Arrow		
Street Names		
Title and Location of Project		
INDEX MAP		
Scale _____		
North Arrow		
Proposed Water/Sewer Line		
Layout of Project		
Appurtenances		
Manhole		
Fire Hydrants		
Detector Checks		
Air Valves		
Blow-Offs		
Pipeline		
Quantities		
Plan Layout/Sheet Reference		
NOTES		
Sewer System Certification		
Notifications		
General Sewer Notes		
LLWD Signature Block		

LEE LAKE WATER DISTRICT
SEWER CONSTRUCTION DRAWINGS CHECK LIST

TRACT NO. _____ LLWD W.O. _____

PROFILE

SHEET NO.												
Stations at Bottom of Profile												
Elevations at Side of Profile												
Existing Ground Surface												
Proposed Finished Ground Surface or Pavement												
Match Lines (Station & Sheet Number)												
Flow line of Sewer Identified												
Stationing and Flow Line Elevations for.												
a. Manholes												
b. Grade Breaks												
c. End of Pipe												
Sewer Slopes												
Sewer Lengths												
7' Minimum Cover												
Separation from Water												

LEE LAKE WATER DISTRICT
SEWER CONSTRUCTION DRAWINGS CHECK LIST

TRACT NO. _____ LLWD W.O. _____

PLAN

SHEET NO.												
LLWD Signature Block												
Title Block												
Scale (Hor. – 1" =40') (Vert. – 1" = 4')												
North Arrow												
Location and Width of Right-of-Way												
Location and Width of Curb Separation												
Location and Width of Easements												
Street Names												
Lot (Parcel) Lines & Numbers, All Adjacent Tracts Identified												
Existing/Future Utilities												
Existing/Proposed Improvements												
Match Lines (Station & Sheet Number)												
Existing Sewer Dwg. Reference												
Sewer Located per County Standard No. 817 and Identified												
Separation from water												
Stations and O.D. Elevations of Crossings (water, Sewer, Storm drain, and reclaimed water)												
Centerline Offset to Proposed Sewer and Other Utilities												
Centerline Stationing (100' tick marks with Station)												
Centerline Curve Data												
Type and Size of Proposed Sewer												
Lateral Connection (Sizes, Approximate Locations)												
Manhole Locations												

APPENDIX H
GRANT OF EASEMENT

WHEN RECORDED, MAIL TO:

LEE LAKE WATER DISTRICT
22646 Temescal Canyon Road
Corona, California 92883

NO RECORDING FEE PER GOVT CODE 6103 & 27383

APN
TRA:

TRANSACTION EXEMPT FROM DOCUMENTARY
TRANSFER TAX PER REV. & TAX CODE 11922

DEED OF EASEMENT

For valuable consideration, receipt of which is hereby acknowledged, _____, Grantor, hereby grants to LEE LAKE WATER DISTRICT, Grantee, a permanent easement and right of way for the installation, operation, maintenance, repair and replacement of a pipeline or pipelines, together with incidental appurtenances, connections and structures in, over, under, upon, along, through and across the real property situated in the County of Riverside, State of California, described on Exhibit A hereto, and as depicted on Exhibit B.

Together with the right to grade and improve said right of way and to enter upon and pass and repass over and along said strip of land for the construction, operation and maintenance, repair and replacement of the pipeline or pipelines, appurtenances, connections and structures to be constructed in said easement by the Lee Lake Water District.

It is understood and agreed that the easement and right of way hereby granted is subject to the right of the servient owner, his successors and assigns, to use the surface of the land within said easement and right of way to the extent that such use is compatible with the full and free exercise of said easement and right of way by the Lee Lake Water District; provided however, that no trees, vegetation, fences, block walls, or other structures or other improvements shall be constructed upon, across or over said easement and right of way, nor shall owner place or maintain any fill or paving of any nature over the surface of the easement, nor remove any earth from the cover of said pipeline or other facility after construction.

DATED: _____

Company Name

A _____ Corporation

By: _____
Name

[illegible]

On _____, before me, _____, a Notary Public in and for said County and State, personally appeared _____, personally known to me (or proved to me on the basis of satisfactory evidence) to be the person whose name is subscribed to the within instrument and acknowledged to me that he executed the same in his authorized capacity, and that by his signature on the instrument, the entity upon behalf of which the person acted, executed the instrument.

WITNESS me hand and official seal.

Signature_____

(Seal of Notary)

PLAT REQUIREMENTS

1. North Arrow
2. Subdivision Title With Recording Data
3. Lot of Parcel #'s
4. Street Names
5. Right-Of-Way Widths
6. Townships, Sections and Ranges
7. All Distances, Bearings and References Stated
With Legal Description
8. Point Of Beginning
9. Bold and Distinct Line Around Proposed
Easement
10. Scale
11. RCE / LS Signature and Stamp

LEE LAKE WATER DISTRICT

This Plat Is solely An Aid In Locating The Parcel(S) Described In The Attached Document.
It Is Not A Part Of The Written Description Therein.

SHEET

EXHIBIT

PREPARED BY:

SUBJECT:

OF _____ SHEET(S)

SCALE: 1"= _____ DRAWN BY: _____ DATE: _____ CHECKED BY: _____

W.O.# _____

PLAT REQUIREMENTS

1. North Arrow
2. Subdivision Title With Recording Data
3. Lot of Parcel #'s
4. Street Names
5. Right-Of-Way Widths
6. Townships, Sections and Ranges
7. All Distances, Bearings and References Stated With Legal Description
8. Point Of Beginning
9. Bold and Distinct Line Around Proposed Easement
10. Scale
11. RCE 1 LS Signature and Stamp


This Plat Is solely An Aid In Locating The Parcel(S) Described In The Attached Document. It Is Not A Part Of The Written Description Therein.

LEE LAKE WATER DISTRICT

EXHIBIT	PREPARED BY:	SUBJECT:	SHEET
		OF ____ SHEET(S)	
		SCALE: 1"= _____ DRAWN BY: _____ DATE: _____ CHECKED BY: _____ W.O.# _____	

APPENDIX I
FLOWCHART FOR CONSTRUCTION OF SEWER FACILITIES

FLOWCHART FOR CONSTRUCTION OF SEWER FACILITIES

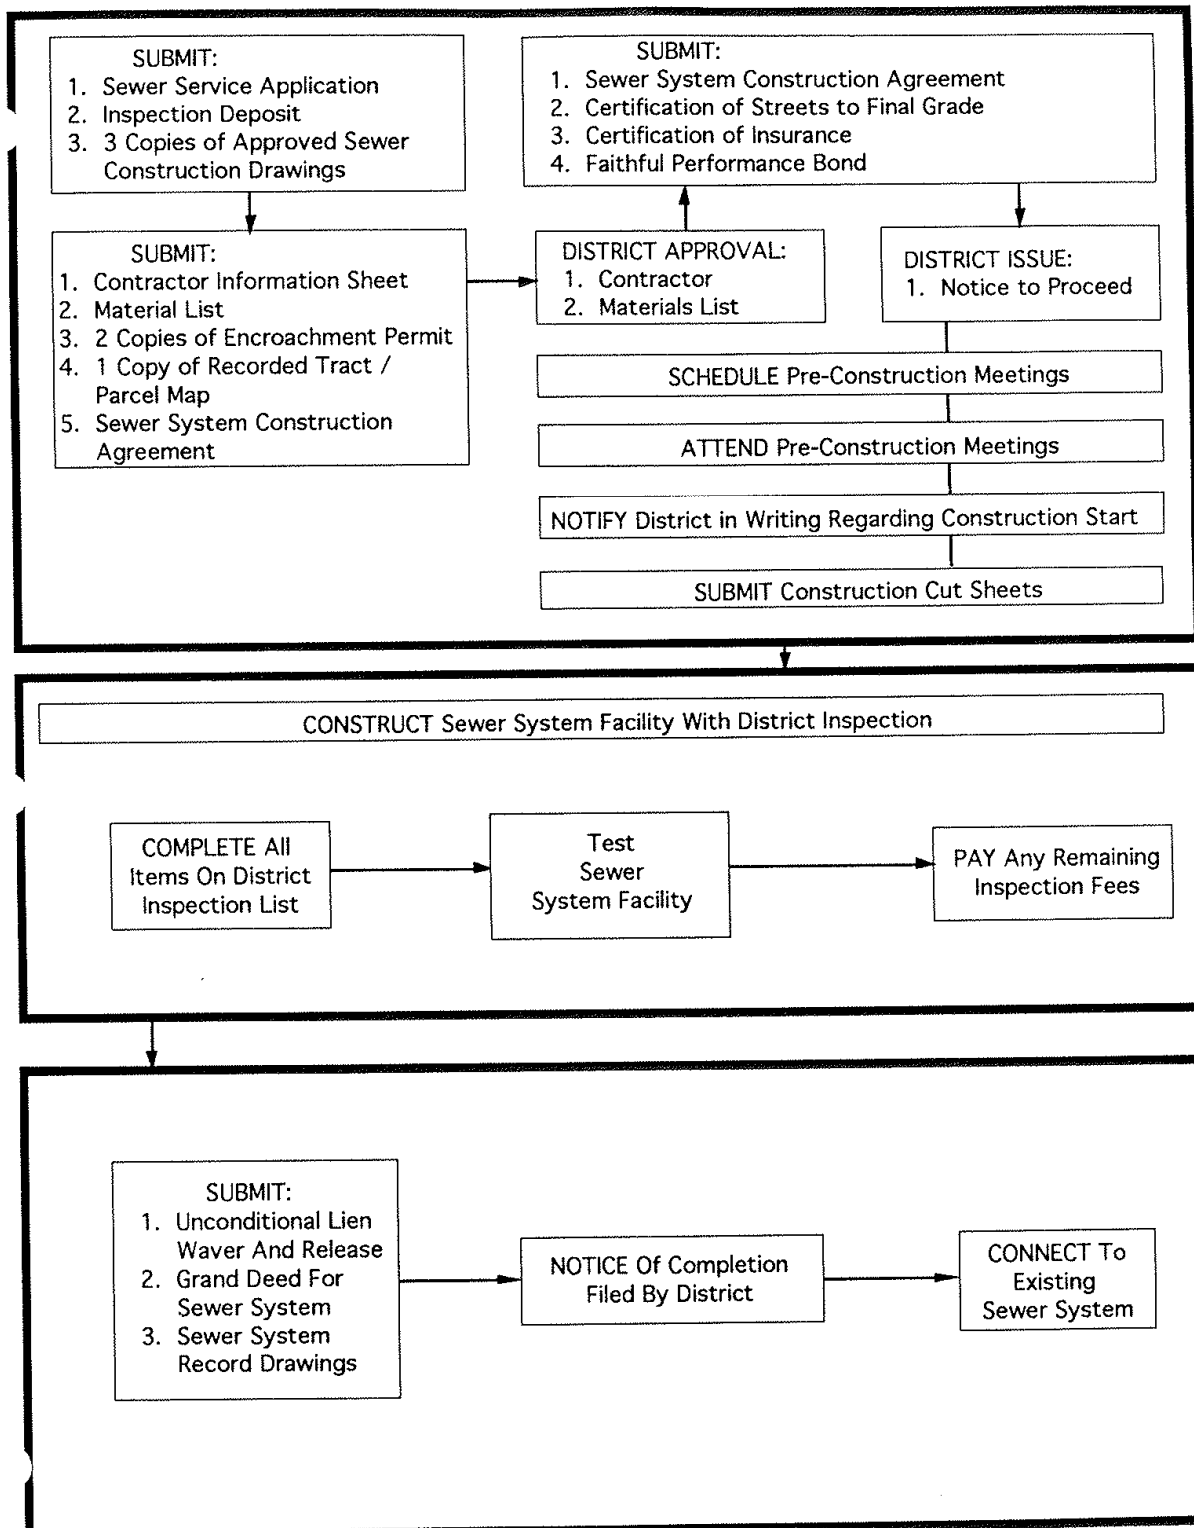

APPENDIX "I"

APPENDIX "J"
CONSTRUCTION STATUS SHEET

CONSTRUCTION STATUS REPORT

LLWD Job No. _____ Inspector _____

Location: _____

Developer: _____

Contractor: _____

RECEIVED	APPROVED	SUBMITTED
----------	----------	-----------

_____	_____	Engineering Service Application
_____	_____	Inspection Deposit
_____	_____	Approved Sewer Construction Drawings (3 Sets)
_____	_____	Contractor Information Sheet
_____	_____	Materials List
_____	_____	Encroachment Permit (2 Copies)
_____	_____	Recorded Tract/Parcel Map (1 Copy)
_____	_____	Sewer System Construction Agreement
_____	_____	Contract for Water System Construction
_____	_____	Certification of Streets to Final Grade
_____	_____	Certificates of Insurance
_____	_____	Faithful Performance Bond

DATE

_____	Notice to Proceed issued by District
_____	Preconstruction Meeting Conducted
_____	Received Cut Sheets
_____	Installed Sewer and all Appurtenances
_____	Completed all Items on Inspectors Deficiency List

DATE

_____ Received County Campaction Tests Sign-off

_____ Tested Sewer System

_____ All Remaining Fees and Charges Paid

RECEIVED APPROVED SUBMITTED

_____ _____ Unconditional Lien Waiver and Release

_____ _____ Sewer System Grant Deed

_____ _____ Record Drawings

DATE

_____ Filed Notice of Completion

_____ Connection(s) to Existing System Completed

APPENDIX K
CONTRACTOR INFORMATION SHEET

CONTRACTOR INFORMATION SHEET

Firm Name and Address: _____

Contractor's License No.: _____

License Class: _____

License Expiration Date: _____

Telephone No.: _____

Emergency Telephone No.: _____

Contractor's Project Manager:

Name: _____

Telephone No.: _____

Emergency Telephone No.: _____

Contractor's Superintendent:

Name: _____

Telephone No.: _____

Emergency Telephone No.: _____

Contractor's Signature: _____ Date: _____

Received: Lee Lake Water District:

By: _____ Date: _____

Contractor shall furnish three references for similar projects completed within the past three (3) years.

<u>Contract Amount</u>	<u>Type of Work</u>	<u>Date Completed</u>	<u>Owner (Name & Address)</u>	<u>Person in Charge of Project</u>	<u>Phone Number of Person in Charge</u>

APPENDIX L
SEWER SYSTEM CONSTRUCTION AGREEMENT

LEE LAKE WATER DISTRICT OF RIVERSIDE COUNTY
SEWER SYSTEM CONSTRUCTION AGREEMENT (DEVELOPER
INITIATED/CONTRACTOR INSTALLED)

THIS AGREEMENT is made of this _____ day of _____, 20____, by and between LEE LAKE WATER DISTRICT OF RIVERSIDE COUNTY, A California Water District, hereinafter designated as the "District", and _____

located at _____

Telephone No. _____, represented by _____
hereinafter designated as the "Developer".

WHEREAS, Developer is planning a _____ (Tract)
consisting of _____ residential (commercial) lots known as _____
_____, records of Riverside County,
California, as further shown on the map attached hereto as Exhibit A, and which is hereinafter
referred to as the "Development"; and

WHEREAS, said subdivision will require a sewer system to provide domestic sewer
service to the Development; and

WHEREAS, Developer is desirous of having the District provide domestic sewer service to
the Development and is willing to convey to the District the sewer system after the construction
thereof, contingent upon the District's acceptance of such conveyance on the terms and conditions
set forth herein.

NOW, THEREFORE, THE PARTIES AGREE AS FOLLOWS:

1. District agrees to provide domestic sewer service to the Development on the terms
and conditions hereinafter provided and subject to all of the District's rules, regulations,
ordinances, orders and rates.

2. Developer agrees to construct the sewer system facilities necessary for aforesaid
Development in accordance with the following terms and conditions:

A. Developer will cause all of the sewer system pipelines and facilities
necessary or desirable to serve the Development to be constructed at Developer's expense.
The required pipelines and facilities are hereinafter referred to as the "Sewer System".

B. Developer will cause the Sewer System plans, specifications and
construction drawings to be prepared at Developer's expense and submit said materials to

District for its approval which approval must be obtained prior to letting any contract or allowing construction. The plans, specifications and drawings shall fully comply with all applicable rules, regulations and ordinances of District including, but not limited to, District's "Standard Specifications on Standard Drawings for Sewer and Sewer Facilities".

C. All construction of Sewer System shall be done by qualified and properly licensed contractors. The prime contractor for the work shall be required to have a "C-34" or General Engineering "A" license and shall be experienced in the construction of domestic sewer systems. The qualifications of the prime contractor for the work must be approved by District in advance of any work being done on the system.

D. Sewer construction drawings for said Sewer System shall be approved by District prior to the presentation thereof to contractors for bidding purposes and said Sewer System shall be constructed and installed in full compliance with said approved sewer construction drawings and District specifications referenced in paragraph B above.

E. Prior to acceptance of the Sewer System by District, District will require:

- (1) Submittal to District of _____ sets of "as built" drawings.
- (2) Evidence satisfactory to District that Developer can grant the Sewer System to District free and clear of all liens, claims and encumbrances.
- (3) Evidence satisfactory to District and subject to physical inspection that the Sewer System has been constructed pursuant to the terms and conditions of this Agreement and is in good condition and repair.
- (4) A Faithful Performance Bond satisfactory to District bonding compliance with this Agreement and the terms and conditions hereof.
- (5) All fees and charges of District have been paid in full.
- (6) An unconditional lien waiver release.
- (7) Recordation of the Notice of Completion.
- (8) A form of Grant Deed of the Sewer System satisfactory to District.

F. District will not accept the Sewer System or be responsible for it in any way until District has accepted the Sewer System in writing. Any damage to the Sewer System prior to acceptance will be solely the responsibility of Developer.

G. Developer will protect all existing District Facilities in place and will immediately repair or replace any District facility damaged as a result of work or other activity in connection with the Development.

H. Developer will pay, on demand, all costs incurred by District in connection with this Agreement including, but not limited to, the cost to District of an inspector or inspectors to inspect the work in progress and the completed work for compliance with this Agreement and testing if reasonably required. All rates paid will be reasonable and in accord with local applicable rates at the time of inspection, review or testing.

3. Construction shall not begin until District issues a "Notice to Proceed". Prior to District issuing "Notice to Proceed", Developer shall submit the following:

A. Copy of contract between Developer and Contractor verifying cost of Sewer System construction.

B. Certification of streets to final grade.

C. Certificates of insurance for contractor and all subcontractors in a form satisfactory to District. The insurance company shall be rated A in the latest issue of Best's Key Rating Guide, Property-Casualty, Written by A. M. Best Company.

D. A faithful performance bond with corporate surety or sureties satisfactory to the District. The bonding company shall be rated A in the latest issue of Best's Key Rating Guide, Property-Casualty, Written by A. M. Best Company) on District form. If separate City/County bonding is required, Developer can submit approved City/County bonding in lieu of District bond. Said performance bond shall be for not less than one hundred percent (100%) of the total contract price. Said bond guarantees the completion of the Sewer System (including submission of the Unconditional Lien Waiver and Release and the Sewer System Grant Deed) and guarantees the materials and workmanship of the installed domestic Sewer System against failures of any type for one (1) year from the date of the filing of the "Notice of Completion". Said bond shall provide for the payment of all costs incurred by the District for the repair of such failures within the one (1) year guarantee period.

4. In the event construction of the Sewer System does not commence prior to _____, 20____, District may, at its option, cancel this Agreement by written notice to Developer; provided, however, that in the event such cancellation does not occur within sixty (60) days after said date, such cancellation shall require sixty (60) days' advance notice and, if construction commences during the sixty (60) day notice period, the cancellation shall not be effective.

In the event the Sewer System has not been accepted by District prior to _____, 20____, District may, at its option, cancel this Agreement upon sixty (60) days' written notice to Developer. If during the sixty (60) day notice period, Developer completes the Sewer System

and complies with the conditions precedent to acceptance of the Sewer System by District, the cancellation shall not be effective.

In the event of cancellation under this paragraph, District's obligation to accept the Sewer System and to furnish sewer service to the Development shall cease and District shall retain all amounts previously paid to District hereunder.

Nothing herein shall be construed to prevent District from accepting the Sewer System or furnishing sewer service to the Development on such other terms and conditions as District may agree.

5. Developer agrees to indemnify and save District, its employees and agents free and harmless from any and all liabilities, loss, damage or injury to persons or property arising out of or in connection with construction of the Sewer System as herein provided.

6. In the event either party brings an action in court to enforce any term, provision or condition hereof, or to recover damages for any default hereunder, the prevailing party shall be entitled to recover its reasonable attorney's fees.

7. This Agreement is not assignable by Developer without the express written consent of District. Subject to that condition, this Agreement shall be binding upon and inure to the benefit of the successors and assigns of the parties hereto.

8. Whenever in this Agreement notice is required to be given, the same shall be given by certified mail, postage prepaid, addressed to the respective parties at the following addresses:

To District: LEE LAKE WATER DISTRICT
 22646 Temescal Canyon Road
 Corona, California 92883

To Developer: _____

9. This Agreement contains all of the terms, conditions and agreements of the parties relating to the subject matter hereof and no amendment or alteration hereof shall be effective for any purpose unless contained in a writing duly executed by the parties hereto.

IN WITNESS WHEREOF, the parties hereto have executed this Agreement on the day and year first above written.

LEE LAKE WATER DISTRICT

By: _____

General Managers

Date: _____

DEVELOPER

Company: _____

By: _____

Name: _____

Title: _____

Date: _____

APPENDIX M
CERTIFICATION OF STREETS TO FINAL GRADE

TO: LEE LAKE WATER DISTRICT

FROM: _____

(ADDRESS) _____

SUBJECT: Certification of Streets to Final Grade

Tract Map No. _____, or

Parcel Map No. _____

1. There has been executed a "SEWER SYSTEM CONSTRUCTION AGREEMENT" for the sewer mains described above; said Agreement being between:

a. The Lee Lake Water District, hereinafter designated as the "District";

b. _____
hereinafter designated as the "Developer".

All terms and conditions of said Agreement are hereby incorporated by reference.

2. Pursuant to Section 3 of said Agreement, the Developer certifies that all streets requiring sewer mains are to the required Final Grade and ready for installation of sewer mains; wherein the Final Grade shall be defined as the finished grade of the street base or sub-base required by the Riverside County Road Department, or the District.

3. Developer agrees that if there is a change required in the final grade of the street which occurs during or after the construction of the sewer mains, and requires the relocation of any sewer facilities, the Developer will make full payment for all costs necessary to relocate said sewer facilities.

Developer: _____

Address: _____

City/State/Zip: _____

Telephone: _____

Authorized Agent (sign): _____

Name (type): _____

Title: _____

APPENDIX N
CERTIFICATE OF INSURANCE

CERTIFICATE OF INSURANCE **LEE LAKE WATER DISTRICT**

This certifies to the LEE LAKE WATER DISTRICT, located at 22646 Temescal Canyon Road, Corona, California 92883, that the following described policies have been issued to:

Insured: _____

 Address: _____

Coverage is provided for the following operation(s)/locations(s):

			Limits of Liability in thousands (000) Policy Covers	
Type of Insurance	Insurer of Policy No.	Policy Expiration Date	Each Occurrence	Aggregate
GENERAL LIABILITY-"Occurrence" Policies Only				
<input type="checkbox"/> Comprehensive Form		BODILY		
<input type="checkbox"/> Premises-Operations		INJURY	\$	\$
<input type="checkbox"/> Owners & Contractors Protective				
<input type="checkbox"/> Blanket Contractual		PROPERTY		
<input type="checkbox"/> Products and/or		DAMAGE	\$	\$
Completed Operations		BODILY	\$	\$
		INJURY		
		& PROPERTY		
<input type="checkbox"/> Explosion & collapse		DAMAGE		
Hazard		COMBINED		
<input type="checkbox"/> Underground Hazard				
<input type="checkbox"/> Broad Form Property Damage				
<input type="checkbox"/> Policy to include severability of interest clause				
<input type="checkbox"/> Personal Injury Exclusion "C" Removed				
		PERSONAL INJURY	\$	\$

(Coverage shall be at least as broad as Insurance Service Office Form No. GL 0002 covering Comprehensive General Liability and Insurance Service Office Form No. GL 004 covering Broad Form Comprehensive General Liability; Broad Form Comprehensive General Liability; or Insurance Service Office Commercial General Liability coverage, Occurrence Form No. CG 0001).

AUTOMOBILE LIABILITY - "Occurrence" Policies Only

<input type="checkbox"/> Comprehensive Form	BODILY INJURY (EACH PERSON)	\$
<input type="checkbox"/> Owned	BODILY INJURY (EACH OCCURRENCE)	\$
<input type="checkbox"/> Hired	PROPERTY DAMAGE	
<input type="checkbox"/> Non-owned	BODILY INJURY PROPERTY DAMAGE COMBINED	\$

(Coverage shall be at least as broad as Insurance Service Office form number CA 0001 covering automobile liability, Code 1 "any auto" and endorsement number CA 0025.)

EXCESS LIABILITY - "Occurrence" Policies Only

<input type="checkbox"/> Umbrella form	BODILY INJURY & PROPERTY DAMAGE	\$
<input type="checkbox"/> Other than umbrella form	COMBINED	
WORKERS COMPENSATION	STATUTORY	\$
<input type="checkbox"/> AND EMPLOYERS' LIABILITY		(EACH ACCIDENT)

(Coverage shall be as broad as required by the Labor Code of the State of California and Employer's liability coverage.)

BUILDERS RISK (FIRE "ALL RISK") - "Occurrence" Policies Only	<input type="checkbox"/> ON 100% OF COMPLETED VALUE BASIS – \$
---	--

The following provisions apply:

1. The Lee Lake Water District, its officers, agents, employees, and consultants are hereby declared to be additional insureds on all of the above-mentioned described liability insurance policies, as respects the operations of the named insured at or from the premises of the Lee Lake Water District described above.

2. The above-described liability insurance policies are primary insurance and no insurance held or owned by the designated additional insureds shall be called upon or looked to in order to cover a loss under said policy; the Lee Lake Water District shall not be liable for the payment of premiums or assessments under these policies.

3. None of the above-described policies will be canceled, limited or non-renewed until thirty (30) days after receipt by the Lee Lake Water District or a written notice of such cancellation or reduction of coverage as evidenced by receipt of a registered letter.

4. The insured(s) issuing the above described workers' compensation and/or builders risk insurance policies waives all rights of subrogation against the Lee Lake Water District, its officers, agents, employees, and consultants, designated as additional insured.

5. Any failure to comply with reporting provisions of the policies shall not affect coverage provided to the Lee Lake Water District, the Owner's Representative, the Engineer/Architect and their officers, agents, employees, consultants, and volunteers.

6. The named insured(s) insurance coverage shall apply separately to each insured against whom claim is made or suit is brought, except with respect to the limits of the insured's liability.

Insurance Agency: _____

Address: _____

Authorized Representative: _____

Phone: _____

Date: _____

APPENDIX O
FAITHFUL PERFORMANCE BOND

BOND NO. _____

FAITHFUL PERFORMANCE BOND

FOR

SEWER SYSTEM CONSTRUCTION AGREEMENT

KNOWN ALL PERSONS BY THESE PRESENTS: That WHEREAS, the Lee Lake Water District, has entered into a Sewer System Construction Agreement (All terms and conditions of said Agreement are hereby incorporated by reference) with _____, as Principal, (hereinafter designated as the "Developer"), for construction of:

_____;

WHEREAS, said Principal is required under the terms of said Agreement to furnish a bond for the faithful performance of said contract.

NOW, THEREFORE, we, _____, as Developer, and _____ as Surety, are held and firmly bound unto the Lee Lake Water District (hereinafter called the "District"), in the sum of _____

DOLLARS (\$ _____) (this amount being not less than one hundred percent (100%) of the total price of the work), lawful money of the United States of America, for payment of which sum well and truly to be made, we bind ourselves, our heirs, executors, administrators and successors, jointly and severally, firmly by these presents.

THE CONDITION OF THIS OBLIGATION IS SUCH THAT, if the hereby bonded Developer, its heirs, executors, administrators, successors, or assigns, shall in all things stand to and abide by and well and truly keep and perform all the undertakings, terms, covenants, and conditions in said Agreement and any alteration thereof, made as therein provided, all within the time and in the manner therein designated in all respects according to their true intent and meaning, then this obligation shall become null and void; otherwise it shall be and remain in full force and effect until Developer has completed construction of the facilities including repair of any damage of existing

District facilities and provided District with an Unconditional Lien Waiver and Release and a Sewer System Grant Deed and has paid all fees and charges.

As a condition precedent to the satisfactory completion of the work (including submission of the Unconditional Lien Waiver and Release, submission of the Sewer System Grant Deed, payment of all fees and charges, and repair of any damage of existing District facilities), the above obligation shall hold good for a period of one (1) year after the completion of the Work and filing of the Notice of Completion by the district, during which time if Developer shall fail to make full, complete, and satisfactory repair and replacements and totally protect the District from loss or damage made evident during the period of one (1) year from the date of filing of the Notice of Completion by the District, and resulting from or caused by defective materials or faulty workmanship, the above obligation in penal sum thereof shall remain in full force and effect. Notwithstanding anything in this paragraph to the contrary, the obligation of Surety hereunder shall continue so long as any obligation of Developer remains.

FURTHER, the said Surety, for value received, hereby stipulates and agrees that no change, extension of time, alteration or modification of the Agreement, or of the work to be performed thereunder, shall in any way affect its obligations on this bond; and it does hereby waive notice of any change, extension of time, alteration or modification of the Agreement or of work to be performed thereunder.

IN WITNESS WHEREOF, two (2) identical counterparts of this instrument, each of which shall for all purposes be deemed an original thereof, have been duly executed by the Developer and Surety named therein, on the day of ____, 20__ , the name and corporate seal of each corporate party being hereto affixed and these presents duly signed by its undersigned representative pursuant to authority of its governing body.

Developer (seal)

Name: _____

Title: _____

Signature: _____

Surety (seal)

Name: _____

Title: _____

Signature: _____

Address: _____

APPROVED AS TO FORM:

Clayson, Mann, Arend & Yeager

District Legal Counsel

By: _____

(SEAL AND NOTARIAL
ACKNOWLEDGEMENT OF SURETY)

APPENDIX P
UNCONDITIONAL LIEN WAIVER AND RELEASE

UNCONDITIONAL LIEN WAIVER AND RELEASE

DATE: _____

TO WHOM IT MAY CONCERN:

The undersigned has been paid in full for all labor, services, equipment or materials furnished to _____ ("Contractor") on the job for the Lee Lake Water District ("District") located at _____ in the County of Riverside, State of California ("Property").

The undersigned does hereby waive and release Contractor and District from any and all liability for liens for all materials delivered and labor performed by it, all Mechanic's Liens, including ones that have been recorded, Stop Notices, or any right against a Labor and Material Bond, to or for the Job and the Property on which it is located.

This Unconditional Lien Waiver and Release, materials and Labor, is made in accordance with Civil Code s3262 and s5 of the Sewer System Construction Agreement between Lee Lake Water District and Developer _____, dated _____.

NOTICE: THIS DOCUMENT WAIVES RIGHTS UNCONDITIONALLY AND STATES THAT YOU HAVE BEEN PAID FOR GIVING UP THOSE RIGHTS. THIS DOCUMENT IS ENFORCEABLE AGAINST YOU IF YOU SIGN IT, EVEN IF **YOU HAVE NOT BEEN PAID**. IF YOU HAVE NOT BEEN PAID, USE A CONDITIONAL RELEASE FORM.

Firms Name

Address

City, State

By: _____
Authorized Representative

APPENDIX Q
SEWER SYSTEM GRANT DEED

W.O. _____

SEWER SYSTEM GRANT DEED

FOR VALUABLE CONSIDERATION paid and received,

_____ hereby grant(s) to Lee Lake Water District all right, title and interest in the sewer system improvements for the entire sewer system facilities for the development referenced with records of the County of Riverside, State of California as _____ and agrees to indemnify the District for any and all claims, liens, causes of action or any type of liability arising from or in any way related to the construction of said facilities.

Said sewer system improvements are shown in detail on the construction drawings {Sheets _____ thru _____} for said development. This Grant Deed is in accordance with Section 5 of the Sewer System Agreement between Lee Lake Water District and dated _____, and is effective upon Developer providing the Unconditional Lien Waiver and Release and upon filing of the Notice of Completion by the District for the aforementioned sewer system improvements.

SELLERS for his heirs, executors and administrators, covenants and agrees to warrant and defend this sale of property, goods and chattels, against all and every persons claiming the same.

DATE: _____

BY: _____

SEAL AND NOTARIAL ACKNOWLEDGEMENT

APPENDIX R
PEAK FLOW FACTORS

Peak flowrate factor
2.6 used




APPENDIX "R"
PEAK FLOW FACTORS

APPENDIX B

GRAVITY SEWER HYDRAULIC ANALYSIS

Cross Section for A1/B1 8-inch PVC @0.5%


Project Description	
Friction Method	Manning
	Formula
Solve For	Normal Depth
Input Data	
Roughness Coefficient	0.013
Channel Slope	0.500 %
Normal Depth	3.8 in
Diameter	8.0 in
Discharge	0.250 MGD

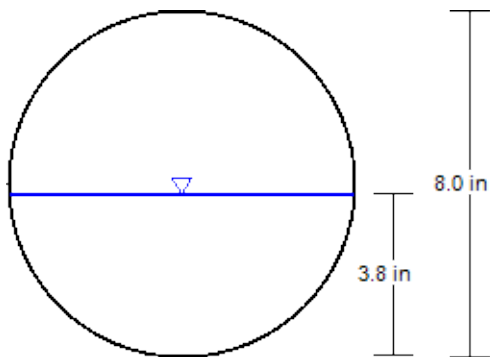

V: 1
H: 1

Cross Section for A2 10-inch PVC @0.5%


Project Description	
Friction Method	Manning
	Formula
Solve For	Normal Depth
Input Data	
Roughness Coefficient	0.013
Channel Slope	0.500 %
Normal Depth	5.0 in
Diameter	10.0 in
Discharge	0.500 MGD

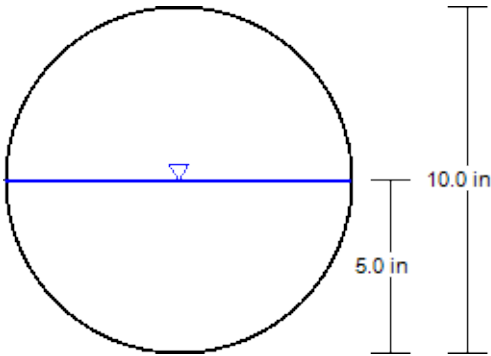

V: 1
H: 1

Cross Section for A3 10-inch PVC @4.9%

Project Description	
Friction Method	Manning
	Formula
Solve For	Normal Depth
Input Data	
Roughness Coefficient	0.013
Channel Slope	4.900 %
Normal Depth	2.9 in
Diameter	10.0 in
Discharge	0.560 MGD

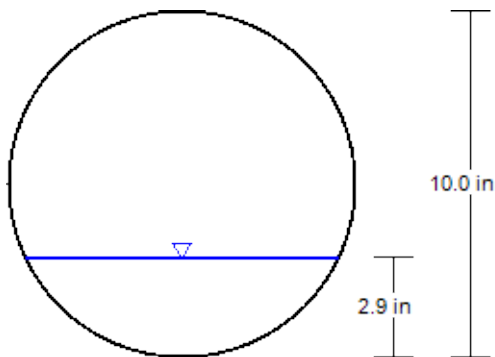

V: 1
H: 1

Worksheet for A1/B1 8-inch PVC @0.5%

Project Description	
Friction Method	Manning
	Formula
Solve For	Normal Depth
Input Data	
Roughness Coefficient	0.013
Channel Slope	0.500 %
Diameter	8.0 in
Discharge	0.250 MGD
Results	
Normal Depth	3.8 in
Flow Area	0.2 ft ²
Wetted Perimeter	1.0 ft
Hydraulic Radius	1.9 in
Top Width	0.67 ft
Critical Depth	3.5 in
Percent Full	47.2 %
Critical Slope	0.671 %
Velocity	2.39 ft/s
Velocity Head	0.09 ft
Specific Energy	0.40 ft
Froude Number	0.853
Maximum Discharge	0.594 MGD
Discharge Full	0.552 MGD
Slope Full	0.102 %
Flow Type	Subcritical
GVF Input Data	
Downstream Depth	0.0 in
Length	0.0 ft
Number Of Steps	0
GVF Output Data	
Upstream Depth	0.0 in
Profile Description	N/A
Profile Headloss	0.00 ft
Average End Depth Over Rise	0.0 %
Normal Depth Over Rise	35.2 %
Downstream Velocity	Infinity ft/s
Upstream Velocity	Infinity ft/s
Normal Depth	3.8 in
Critical Depth	3.5 in
Channel Slope	0.500 %
Critical Slope	0.671 %

Worksheet for A2 10-inch PVC @0.5%

Project Description	
Friction Method	Manning Formula
Solve For	Normal Depth
Input Data	
Roughness Coefficient	0.013
Channel Slope	0.500 %
Diameter	10.0 in
Discharge	0.500 MGD
Results	
Normal Depth	5.0 in
Flow Area	0.3 ft ²
Wetted Perimeter	1.3 ft
Hydraulic Radius	2.5 in
Top Width	0.83 ft
Critical Depth	4.7 in
Percent Full	49.9 %
Critical Slope	0.634 %
Velocity	2.84 ft/s
Velocity Head	0.13 ft
Specific Energy	0.54 ft
Froude Number	0.876
Maximum Discharge	1.077 MGD
Discharge Full	1.001 MGD
Slope Full	0.125 %
Flow Type	Subcritical
GVF Input Data	
Downstream Depth	0.0 in
Length	0.0 ft
Number Of Steps	0
GVF Output Data	
Upstream Depth	0.0 in
Profile Description	N/A
Profile Headloss	0.00 ft
Average End Depth Over Rise	0.0 %
Normal Depth Over Rise	50.0 %
Downstream Velocity	Infinity ft/s
Upstream Velocity	Infinity ft/s
Normal Depth	5.0 in
Critical Depth	4.7 in
Channel Slope	0.500 %
Critical Slope	0.634 %

Worksheet for A3 10-inch PVC @4.9%

Project Description	
Friction Method	Manning
	Formula
Solve For	Normal Depth
Input Data	
Roughness Coefficient	0.013
Channel Slope	4.900 %
Diameter	10.0 in
Discharge	0.560 MGD
Results	
Normal Depth	2.9 in
Flow Area	0.1 ft ²
Wetted Perimeter	0.9 ft
Hydraulic Radius	1.6 in
Top Width	0.75 ft
Critical Depth	4.9 in
Percent Full	28.6 %
Critical Slope	0.649 %
Velocity	6.73 ft/s
Velocity Head	0.70 ft
Specific Energy	0.94 ft
Froude Number	2.871
Maximum Discharge	3.372 MGD
Discharge Full	3.134 MGD
Slope Full	0.156 %
Flow Type	Supercritical
GVF Input Data	
Downstream Depth	0.0 in
Length	0.0 ft
Number Of Steps	0
GVF Output Data	
Upstream Depth	0.0 in
Profile Description	N/A
Profile Headloss	0.00 ft
Average End Depth Over Rise	0.0 %
Normal Depth Over Rise	28.6 %
Downstream Velocity	Infinity ft/s
Upstream Velocity	Infinity ft/s
Normal Depth	2.9 in
Critical Depth	4.9 in
Channel Slope	4.900 %
Critical Slope	0.649 %


APPENDIX C

FIGURES

TEMESCAL COMMERCIAL CONCEPTUAL SEWER STUDY EXHIBIT

LEGEND

- EXISTING GRAVITY SEWER MAIN (SIZE AS NOTED)
- PROPOSED GRAVITY SEWER MAIN (SIZE AS NOTED)

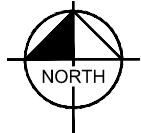

GRAPHIC SCALE IN FEET
0 62.5 125 250

FUTURE
CONNECTION
#2

EXISTING SEWER
MANHOLE

FUTURE
CONNECTION
#1

FUTURE
CONNECTION
#3

LAWSON ROAD

LOT 3
0.21 AC

BEN GARRETT DRIVE (PUBLIC)

A1

A2

A3

B1

KATHERINE WAY (PUBLIC)

LOT 1
10.88 AC

BEN GARRETT DRIVE (PUBLIC)

LOT 2
0.60 AC

EXISTING SEWER
MANHOLE

TEMESCAL CANYON ROAD

Kimley»Horn

© 2023 KIMLEY-HORN AND ASSOCIATES, INC.
1100 TOWN AND COUNTRY RD SUITE 700, ORANGE, CA 92868
PHONE: 714-939-1030

APPENDIX D

**AS-BUILT RECORD DRAWINGS FOR
SEWER LINES**

Lee Lake Water District

LOCATED WITHIN THE:



COUNTY OF RIVERSIDE, STATE OF CALIFORNIA

CONTRACT DRAWINGS FOR:

LEE LAKE WATER TRANSMISSION MAIN AND SEWER TRUNK LINE

PHASE 1B CONSTRUCTION

CONSTRUCTION CONTRACT NO. 91-01

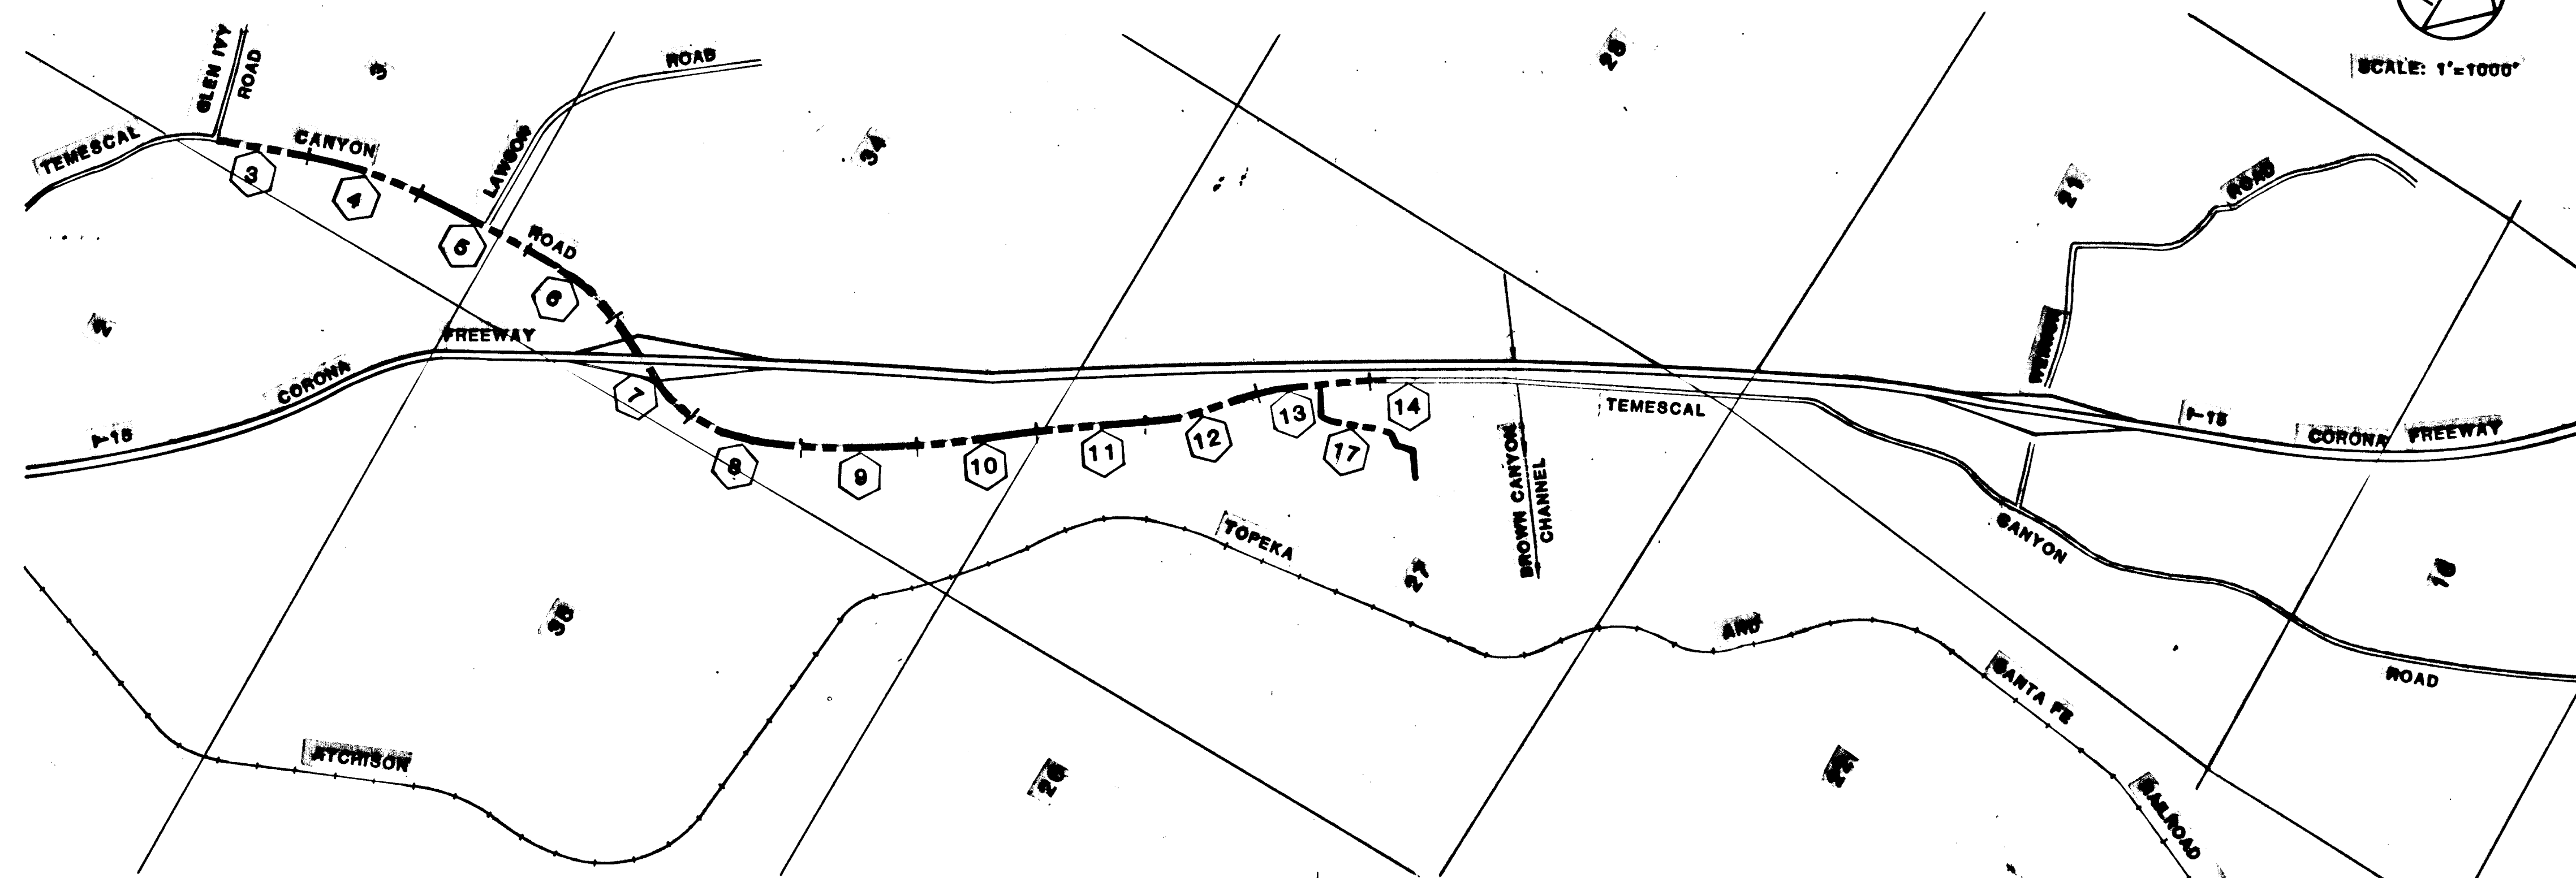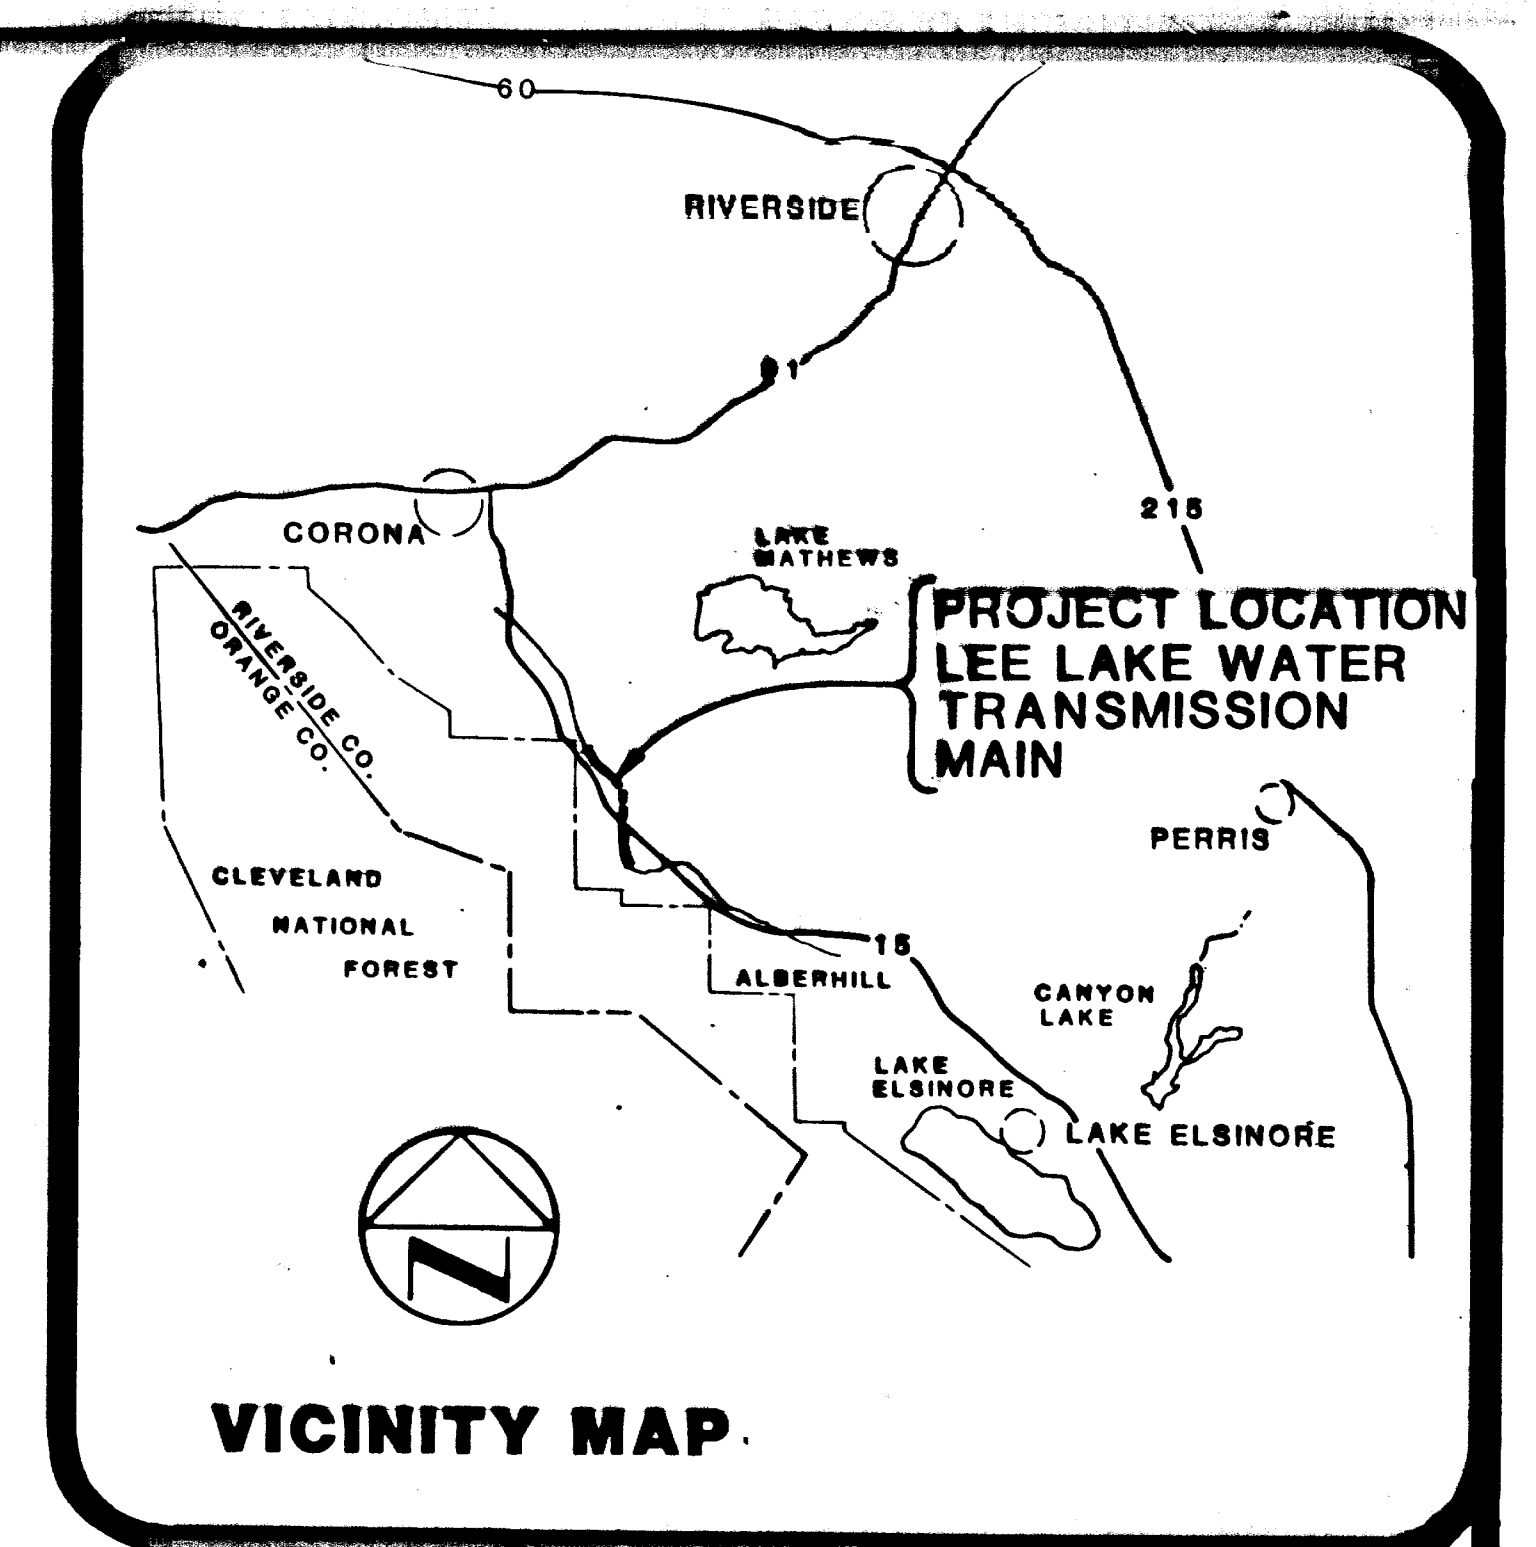

DRAWING INDEX	
DWG. NO.	DESCRIPTION
1	TITLE AND INDEX DRAWING
2	ABBREVIATIONS, LEGEND AND GENERAL NOTES
3-14	PLAN AND PROFILE DRAWINGS
15-16	NOT USED
17	PLAN & PROFILE DRAWINGS
18-20	MISCELLANEOUS DETAILS
21-24	TRAFFIC CONTROL PLAN AT 1-15 ROSSING

LEE LAKE WATER DISTRICT BOARD OF DIRECTORS


DAN ZIMMERMAN
CHARLES W. COLLADAY
JOYCE DELEO
CHRIS CHRISTOFFERSON
LAWRENCE M. WERNER

JOHN S. MURK ENGINEERS, INC.


RECOMMENDED *John S. Murk* DATE *8/27/91*
R.C.E. 22403

LEE LAKE WATER DISTRICT

APPROVED *Kristen A. Row* DATE *10/01/91*
DISTRICT MANAGER

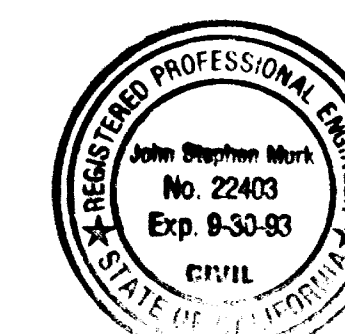

JSME
john s. murk engineers, inc.

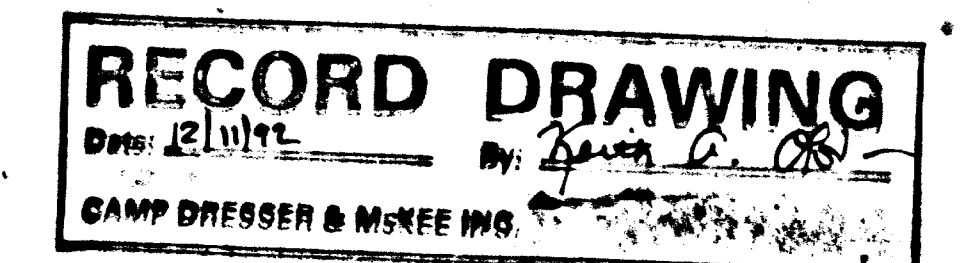

Lee Lake Water District

ABBREVIATIONS

A	Air/Ampere	CTR	Center	H	Height	N	North	SEW	Small End Mechanical Joint
AB	Anchor Bolt	CYRD	Centered	M/A	Hand/Auto	NA	Non-Automatic/Not Applicable	SEN	Sewer
ACB	Air Circuit Breaker	CU	Copper	HB	Hope Bibb	NC	Normally Closed	SP	Square Feet
ACPM	Actual Cubic Feet Per Minute	CB	Control Valve	HC	Handicapped	NCIO	Normally Closed, Instantaneously Open	SHT	Sheet
AC	Asphaltic Concrete/Alternating Current/Air Compressor	OW	Cold Water	HCV	Hand-operated Control Valve	NCTC	Normally Closed, Time Close	SIM	Similar
ACT	American Concrete Institute	CWP	Cold Working Pressure	HDR	Hot Dipped Galvanized Header	NCTO	Normally Closed, Time Open	SK	Skimming
ACD	Asbestos Cement Pipe	D	Drain	HEX	Hexagon	NEC	National Electrical Code	SL	Slope
AF	Ampere Frame	DAV	Disolved Air Flotation Thickener	HEXC	Heat Exchanger	NEG (-)	Negative	SN	Supermatent
APC	Above Finish Concrete	DB	Decibles	HEX	Hexagonal	NEMA	National Electrical Manufacturers Association	S/O	Spare
APF	Above Finish Floor	DC	Direct Current	HEX	Hexagonal	NE	Near Face	SPD	Sump Pump Discharge
APG	Above Finished Grade	DEG	Degrees	HEX	Hexagonal	NG	Natural Gas	SPEC	Specification
AGC	Associated General Contractors	DET, DET'S	Detail, Details	HEX	Hexagonal	NIC	Not In Contr-	SPST	Special Provisions
AGG	Aggregate	DI	Ductile Iron	HEX	Hexagonal	NIP	Nipple	SPST	Single Pole Single Throw
AISC	American Institute of Steel Construction	DIA	Diameter	HEX	Hexagonal	NO. (#)	Number/Normally Open	SPT	Sound Powered Telephone
ALT	Alternate	DIAG	Diagram	HEX	Hexagonal	NOIC	Normally Open, Instantaneously Close	SQ	Square
ALUM	Aluminum	DIP	Ductile Iron Pipe	HEX	Hexagonal	NOM	Normal	SS	Stainless Steel
ANAD	Anaerobic Digester	DIM	Dimension	HEX	Hexagonal	NOTC	Normally Open, Time Close	S/S	Start/Stop Station
ANNUN	Annunciator	DIMJ	Ductile Iron Mechanical Joint	HEX	Hexagonal	NOTO	Normally Open, Time Open	SSPMC	Standard Specification for Public Works Construction
ANSI	American National Standards Institute	DISC	Disconnect	HEX	Hexagonal	NP	Normal	ST	Street
APPROX	Approximate	DISCH	Discharge	HEX	Hexagonal	NPS	National Pipe Size	STA	Station
APWA	American Public Works Association	DISCSW	Disconnect Switch	HEX	Hexagonal	NPT	National Pipe Thread	STD	Standard
AR	Alarm Relay	DPT	Double Pole Double Throw	HEX	Hexagonal	NPS	Non-Potable Water	STIFF	Stiffener
ARCH	Architectural	DPT	Differential Pressure Indicator	HEX	Hexagonal	NPS	Nonrising Stem	STL	Steel
ARV	Air Release Valve	DR	Door	HEX	Hexagonal	NPS	Not To Scale	STR	Structure
AS	Activated Sludge	DRWY	Driveway	HEX	Hexagonal	NV	Needle Valve	SUCT	Suction
ASA	American Standards Association	DS	Digested Sludge	HEX	Hexagonal	OC	On Center	SUP	Support
ASME	American Society of Mechanical Engineers	DWG	Drawing	HEX	Hexagonal	OCA	Open/Close/Auto Switch	SV	Solenoid Valve
ASPH	Asphalt	DWL	Dowel	HEX	Hexagonal	OD	Outside Diameter	SN	Sidewalk/Switch/Solvent
ASSY	Assembly	DWN	Down	HEX	Hexagonal	OF	Outside Face	SHD	Shield
ASTM	American Society for Testing and Materials	DWV	Drain Waste & Vent	HEX	Hexagonal	OH	Overhang	SNP	Standard Working Pressure
AT	Ampere Trip	DWS	Double Extra Strength	HEX	Hexagonal	O/L	Overload Relay	SYM	Symmetrical
AUTO	Automatic	E	East	HEX	Hexagonal	OLAS	Outside Lever & Spring	SYST	System
AUX	Auxiliary	EA	Each	HEX	Hexagonal	OLAW	Outside Lever & Weight	T	Top
AWC	American Wire Gauge	EA	Each	HEX	Hexagonal	OPNG	Opening	TAN	Tangent
AWG	American Wire Gauge	EA	Each	HEX	Hexagonal	OPP	Opposite	TB	Terminal Box
NWS	American Welding Society	EA	Each	HEX	Hexagonal	ORIG	Original	T & B	Top and Bottom
NWT	Advanced Waste Treatment	EA	Each	HEX	Hexagonal	OSAY	Outside Screw & Yoke	TC	Temperature Controller
NWA	American Waterworks Association	EA	Each	HEX	Hexagonal	PA	Plant Air	TCND	Top of Curve
AZ	Azimuth	EA	Each	HEX	Hexagonal	PB	Pushbutton	TDH	Total Dynamic Head
B	Bell	EA	Each	HEX	Hexagonal	P/B	Pullbox	TDR	Time Delay Relay
BC	Beginning of Curve	EA	Each	HEX	Hexagonal	PCC	Precast Concrete	TECH	Technical
BD	Blowdown/Board	EA	Each	HEX	Hexagonal	PCV	Pressure Control Valve	TEL	Telephone
BE	Blind Flange	EA	Each	HEX	Hexagonal	P/C	Plain Concrete	TEMP	Temperature
BFE	Blowoff Effluent	EA	Each	HEX	Hexagonal	PORC	Pressure Differential	TERM	Terminal
BKR	Breaker	EA	Each	HEX	Hexagonal	P/P	Pressure Differential	T & G	Thrust and Groove
BLDG	Building	EA	Each	HEX	Hexagonal	P/P	Pressure Differential	THBA	Thrust Block Bearing Area
BLK	Block	EA	Each	HEX	Hexagonal	P/P	Pressure Differential	THRD	Threaded
BM	Beam	EA	Each	HEX	Hexagonal	P/P	Pressure Differential	THRU	Through
BO	Blow Off	EA	Each	HEX	Hexagonal	P/P	Pressure Differential	TIC	Temperature Indicator
BOD	Biochemical Oxygen Demand	EA	Each	HEX	Hexagonal	P/P	Pressure Differential	TICV	Temperature Control Valve
BNG	Beaker	EA	Each	HEX	Hexagonal	P/P	Pressure Differential	TOG	Top of Grate
BNT	Becket	EA	Each	HEX	Hexagonal	P/P	Pressure Differential	TOP	Top of Pipe
B & S	Bell and Spigot	EA	Each	HEX	Hexagonal	P/P	Pressure Differential	TOS	Top of Steel
BTM, BOT	Bottom	EA	Each	HEX	Hexagonal	P/P	Pressure Differential	TP	Telephone Pole
BTU	British Thermal Unit	EA	Each	HEX	Hexagonal	P/P	Pressure Differential	TS	Thrust Steel/Temperature
BUSH	Bushing	EA	Each	HEX	Hexagonal	P/P	Pressure Differential	TSW	Twisted Shielded
BV	Butterfly Valve	EA	Each	HEX	Hexagonal	P/P	Pressure Differential	TYP	Typical
BWC	Begin Vertical Curve	EA	Each	HEX	Hexagonal	P/P	Pressure Differential	UG	Underground
BW	Bottom Well	EA	Each	HEX	Hexagonal	P/P	Pressure Differential	UL	Underwriters' Laboratories
BWF	Backwash Feed	EA	Each	HEX	Hexagonal	P/P	Pressure Differential	UP	Utility Pole
BWG	Birmingham Wire Gauge	EA	Each	HEX	Hexagonal	P/P	Pressure Differential	UNK	Unknown
BWW	Backwash Waste	EA	Each	HEX	Hexagonal	P/P	Pressure Differential	V	Vent/Volt
C	Channel/Conduit	EA	Each	HEX	Hexagonal	P/P	Pressure Differential	VAC	Vacuum
Ca	Degrees Centigrade	EA	Each	HEX	Hexagonal	P/P	Pressure Differential	VAR	Varies
CB	Caustic	EA	Each	HEX	Hexagonal	P/P	Pressure Differential	VC	Vertical Curve
CB	Catch Basin/Circuit Breaker	EA	Each	HEX	Hexagonal	P/P	Pressure Differential	VCP	Vertical Clay Pipe
CENT	Centrate	EA	Each	HEX	Hexagonal	P/P	Pressure Differential	VERT	Vertical
CD	Ceiling Diffuser	EA	Each	HEX	Hexagonal	P/P	Pressure Differential	VJ	Victaulic Groove Joint
CF	Cubic Feet	EA	Each	HEX	Hexagonal	P/P	Pressure Differential	VJ	Victaulic Shoulder Joint
CFM	Cubic Feet Per Minute	EA	Each	HEX	Hexagonal	P/P	Pressure Differential	VTR	Vent Through Roof
CFM	Cubic Feet Per Second	EA	Each	HEX	Hexagonal	P/P	Pressure Differential	W	West/Watt
CGV	Chlorine Gas Vacuum	EA	Each	HEX	Hexagonal	P/P	Pressure Differential	W	With
CHD	Checked	EA	Each	HEX	Hexagonal	P/P	Pressure Differential	W/O	Without
CH/L	Channel	EA	Each	HEX	Hexagonal	P/P	Pressure Differential	WAS	Waste Activated Sludge
CH-O	Chain-operated	EA	Each	HEX	Hexagonal	P/P	Pressure Differential	WC	Water Closet
CI	Cast Iron	EA	Each	HEX	Hexagonal	P/P	Pressure Differential	WCD	Wall Cleanout
CIB	Cast Iron Inlet Box	EA	Each	HEX	Hexagonal	P/P	Pressure Differential	WO	Wood
CIDJ	Cast Iron Mechanical Joint	EA	Each	HEX	Hexagonal	P/P	Pressure Differential	WV	Welded End
CIP	Cast In Place/Cast Iron Pipe	EA	Each	HEX	Hexagonal	P/P	Pressure Differential	WF	Welded Flange
CIRC	Circular	EA	Each	HEX	Hexagonal	P/P	Pressure Differential	WID	Width
CIRCUM	Circumferential	EA	Each	HEX	Hexagonal	P/P	Pressure Differential	WL	Water Level or Water Line
CISP	Cast Iron Soil Pipe	EA	Each	HEX	Hexagonal	P/P	Pressure Differential	WLD	Weld
CIT	Circuit	EA	Each	HEX	Hexagonal	P/P	Pressure Differential	WOG	Water, Oil, and Gas Pressure
CKV	Check Valve	EA	Each	HEX	Hexagonal	P/P	Pressure Differential	WP	Working Pressure/Weather Proof
CL	Centerline	EA	Each	HEX	Hexagonal	P/P	Pressure Differential	WS	Water Surface Elevation
CLG	Chlorine Gas	EA	Each	HEX	Hexagonal	P/P	Pressure Differential	WSP	Working Steam Pressure/Welded Steel Pipe
CLL	Chlorine Liquid	EA	Each	HEX	Hexagonal	P/P	Pressure Differential	WSTP	Water Stop
CLR	Clearance	EA	Each	HEX	Hexagonal	P/P	Pressure Differential	WT	Weight
CLS	Chlorine Solution	EA	Each	HEX	Hexagonal	P/P	Pressure Differential	WV	Welded Wire Fabric
CLV	Chlorine Vacuum	EA	Each	HEX	Hexagonal	P/P	Pressure Differential	WVW	Woven Wire Mesh/Welded Wire Mesh
CL/L	Centerline/Cement Lined	EA	Each	HEX	Hexagonal	P/P	Pressure Differential	WSP	Welded Steel Pipe
CL/L	Chlorine	EA	Each	HEX	Hexagonal	P/P	Pressure Differential	XH	Extra Heavy
CNC	Cement Mortar Lined and Coated	EA	Each	HEX	Hexagonal	P/P	Pressure Differential	XHFR	Extra Heavy Transformer
CNP	Corrugated Metal Pipe	EA	Each	HEX	Hexagonal	P/P	Pressure Differential	XHTR	Extra Heavy Transmitter
CHV	Concrete Masonry Unit	EA	Each	HEX	Hexagonal	P/P	Pressure Differential	XP	Explosion Proof
CO	Clean Out/Conduit Only	EA	Each	HEX	Hexagonal	P/P	Pressure Differential	XSS	Extra Strong
COL	Column	EA	Each	HEX	Hexagonal	P/P	Pressure Differential	XSH	Double Extra Heavy
COMP	Compartment	EA	Each	HEX	Hexagonal	P/P	Pressure Differential		
CONC	Concrete	EA	Each	HEX	Hexagonal	P/P	Pressure Differential		
COND	Conductor	EA	Each	HEX	Hexagonal	P/P	Pressure Differential		
CONN	Connection	EA	Each	HEX	Hexagonal	P/P	Pressure Differential		
CONST	Construction	EA	Each	HEX	Hexagonal	P/P	Pressure Differential		
CONST JT	Construction Joint	EA	Each	HEX	Hexagonal	P/P	Pressure Differential		
CONT	Continuous/Continued/Control	EA	Each	HEX	Hexagonal	P/P	Pressure Differential		
CONTR	Contractor	EA	Each	HEX	Hexagonal	P/P	Pressure Differential		
CONTR JT	Contractor Joint	EA	Each	HEX	Hexagonal	P/P	Pressure Differential		
CONV	Converter	EA	Each	HEX	Hexagonal	P/P	Pressure Differential		
COTF	Clean Out Through Floor	EA	Each	HEX	Hexagonal	P/P	Pressure Differential		
CP	CP-1 Control Panel, Number As Noted	EA	Each	HEX	Hexagonal	P/P	Pressure Differential		
CPLG	Coupling	EA	Each	HEX	Hexagonal	P/P	Pressure Differential		
CPS	Cycles Per Second	EA	Each	HEX	Hexagonal	P/P	Pressure Differential		
CPVS	Chlorinated Polyvinyl Chloride	EA	Each	HEX	Hexagonal	P/P	Pressure Differential		
CR	Chromium	EA	Each	HEX	Hexagonal	P/P	Pressure Differential		
CS	Contact Relay	EA	Each	HEX	Hexagonal	P/P	Pressure Differential		
CT	Carbon Steel	EA	Each	HEX	Hexagonal	P/P	Pressure Differential		
CT	Circuit Transformer	EA	Each	HEX	Hexagonal	P/P	Pressure Differential		

GENERAL NOTES

- ALL WORK SHALL BE IN ACCORDANCE WITH THESE SIGNED IMPROVEMENT PLANS AND SPECIAL PROVISIONS AND THE ADOPTED STANDARDS AND SPECIFICATION OF THE LEE LAKE WATER DISTRICT.
- THE EXISTING UNDERGROUND UTILITIES SHOWN ARE PER THE PLANS FURNISHED BY THE RESPECTIVE UTILITY COMPANIES AND OTHER AVAILABLE PUBLIC RECORDS.
- THE CONTRACTOR IS RESPONSIBLE FOR LOCATING AND PROTECTING ALL EXISTING UTILITIES DURING CONSTRUCTION. THE ACTUAL LOCATION AND ELEVATION OF ALL EXISTING UNDERGROUND UTILITIES ARE TO BE VERIFIED BY THE CONTRACTOR AND ANY DISCREPANCY IS TO BE BROUGHT TO THE ATTENTION OF THE ENGINEER AND LEE LAKE WATER DISTRICT.
- IT SHALL BE THE RESPONSIBILITY OF THE CONTRACTOR TO KEEP AN "AS-BUILT" RECORD OF ALL WATER MAINS, SEWER LINES AND APPURTENANCES INSTALLED UNDER THIS CONTRACT AND PROVIDE SAID RECORDS TO THE ENGINEER AT THE COMPLETION OF THE PROJECT.
- A PRECONSTRUCTION CONFERENCE SHALL BE HELD AT THE SITE PRIOR TO THE BEGINNING OF THE WORK AND SHALL BE ATTENDED BY ALL REPRESENTATIVES RESPONSIBLE FOR CONSTRUCTION, INSPECTION, SUPERVISIONS, TESTING, UTILITY COMPANIES AND ALL OTHER ASPECTS OF THE WORK.
- WHERE AN EXISTING ABANDONED PIPE LINE IS NOT REMOVED BY THE CONSTRUCTION OPERATION, IT SHALL BE REMOVED WITHIN THE TRENCH WALLS, PROPERLY FLAGGED WITH CONCRETE AND REPLACED WITH PROPERLY COMPACTED SOILS.
- THE CONTRACTOR SHALL BE RESPONSIBLE FOR THE Dewatering of ALL TRENCHES AND FOR THE FURNISHING AND SUPPLYING ALL NECESSARY IMPLEMENTS, PUMPS, PIPES AND ALL OTHER SUPPLIES NECESSARY TO ACCOMPLISH SAID DEWATERING.
- ALL AREAS SHALL BE GRADED TO DRAIN. NO FLOODING OF WATER WILL BE PERMITTED.
- THE CONTRACTOR SHALL BE RESPONSIBLE FOR ANY DEBRIS OR DAMAGE OCCURRING ALONG THE HAUL ROUTES OR ADJACENT STREETS AS A DIRECT RESULT OF HIS TRENCHING OPERATION.
- THE CONTRACTOR SHALL OBTAIN AN EXCAVATION PERMIT FROM THE STATE OF CALIFORNIA, DIVISION OF INDUSTRIAL SAFETY PRIOR TO STARTING CONSTRUCTION AND SHALL MAKE A COPY AVAILABLE TO LEE LAKE WATER DISTRICT.
- ALL EXISTING FACILITIES THAT ARE MOVED OR REMOVED DURING CONSTRUCTION OR ARE PAVED OVER, INCLUDING VALVES BOXES AND COVERS, SHALL BE REINSTALLED AT A PROPER ELEVATION AND LOCATION PER THE SPECIAL PROVISIONS.
- AN ENCROACHMENT PERMIT IS REQUIRED BEFORE ANY WORK MAY BEGIN IN OR NEAR THE STATE RIGHT-OF-WAY.
- ALL WORK WITHIN THE STATE RIGHT-OF-WAY SHALL CONFORM TO THE LATEST STATE STANDARD PLANS & SPECIFICATIONS OR AS DIRECTED BY THE STATE'S REPRESENTATIVE (STANDARDS OTHER THAN STATE MUST BE PRE-APPROVED AND JUSTIFIED.)
- NO EQUIPMENT OR MATERIALS MAY BE STORED ON THE STATE RIGHT-OF-WAY.
- ALL DISTURBED AREAS IN THE STATE RIGHT-OF-WAY MUST BE TREATED FOR EROSION CONTROL (HYDROSEEDING OF EQUIVALENT, OR AS DIRECTED BY THE STATE'S REPRESENTATIVE). THE RESPONSIBILITY FOR MAINTAINING EROSION CONTROL WILL NOT BE RELEASED UNTIL THE SEEDING IS WELL ESTABLISHED. THE CONTRACTOR WILL BE RESPONSIBLE FOR THE COST OF CALTRANS CLEANING ANY DRAINAGE STRUCTURES/CHANNELS WHICH HAVE BECOME CLUTTERED WITH DEBRIS AND/OR SILT AS A RESULT OF, OR CAUSED BY, THE CONSTRUCTION PROJECT.
- ACCESS CONTROL ON THE FREEWAY WILL BE MAINTAINED AT ALL TIMES, I.E., THE WORK INSIDE THE STATE RIGHT-OF-WAY MUST BE PERFORMED WITH NO ACCESS TO THE WORK AREA FROM THE FREEWAY.
- NO FREEWAY RAMP OR FREEWAY LANES MAY BE CLOSED OR OBSTRUCTED AT ANYTIME UNLESS SPECIFICALLY ALLOWED PER THE ENCROACHMENT PERMIT AND/OR AS DIRECTED BY THE STATE'S REPRESENTATIVE.
- THE STRUCTURAL SECTION SHOWN WITHIN THE STATE RIGHT-OF-WAY IS FOR ESTIMATING PURPOSES ONLY. THE ACTUAL SECTION WILL BE DESIGNED BY A SOIL ENGINEER AFTER NATIVE SOIL TESTING HAS BEEN COMPLETED. A TRAFFIC INDEX (TI) OF 10 SHALL BE USED IN THE DESIGN OF THE TRAVELED WAY, AND A TI OF 10 SHALL BE USED FOR THE SHOULDER DESIGN. THE LABORATORY REPORTS AND THE DESIGN CALCULATIONS SHALL BE SUBMITTED TO THE STATE'S REPRESENTATIVE FOR APPROVAL PRIOR TO CONSTRUCTION OF THE STRUCTURAL SECTION.
- WHERE SURVEY MONUMENTS EXIST, SUCH MONUMENTS SHALL BE PROTECTED OR SHALL BE REFERENCED AND RESET PURSUANT TO BUSINESS AND PROFESSIONS CODE, SECTIONS 8700 TO 8805 (LAND SURVEYOR'S ACT.)
- ALL SIGNS, ROADSIDE MARKERS, ETC., SHALL BE PROTECTED AND/OR REPLACED IN-KIND ACCORDING TO THE CURRENT STATE STANDARD PLANS AND THE CURRENT TRAFFIC MANUAL, AT NO COST TO THE STATE.

LEGEND

CONTROL OR STREET CENTERLINE

STREET RIGHT-OF-WAY LINE

EXISTING WATER LINE

EXISTING GAS LINE

EXISTING TELEPHONE CONDUITS

EXISTING ELECTRICAL CONDUITS

EXISTING STORM DRAINS

PROPOSED WATER LINE

PROPOSED WATER VALVE

PROPOSED BLOW-OFF

PROPOSED AIR RELEASE VALVE

PROPOSED SEWER LINE

PROPOSED SEWER MANHOLE

PROPOSED CORROSION TEST STATION

PROPOSED VALVE INSULATOR TEST STATION

EXISTING PAVEMENT

NOTES OF BEARINGS

THE BASIS OF BEARINGS FOR THESE PLANS IS THE CENTERLINE OF TEMESCAL CANYON ROAD ADJACENT TO PARCEL 4 OF PARCEL MAP NO. 19201 AS FILED IN BOOK 129, PAGES 36 TO 42 OF PARCEL MAPS, RECORDS OF THE COUNTY OF RIVERSIDE AND NOTED AS NORTH 28°17'06" WEST.

BENCHMARK

USC & GS, 5316-1935
910.868
0.6 MILES SOUTHERLY ALONG TEMESCAL CANYON ROAD FROM WEIRICK ROAD; 26 FEET ± WESTERLY OF THE EDGE OF PAVEMENT OF TEMESCAL CANYON ROAD; 24 FEET ± SOUTHERLY OF POLE NO. 1607913-E; 94 FEET ± NORTHWESTERLY OF POLE NO. 104241-H; 5 FEET ± WESTERLY OF 4" BARBED WIRE FENCE; 55 FEET ± WESTERLY OF THE EASTERLY ASPHALT BERM OF THE I-15 FREEWAY; A STANDARD 3-1/2" DIAMETER BRASS DISK IN 6" X 6" CONCRETE POST, SET FLUSH WITH THE GROUND AND STAMPED 5316-1935. STANDARD USCG WITNESS POST FOUND 1.0 FEET WESTERLY.

NOTIFICATIONS

- THE CONTRACTOR SHALL NOTIFY RIVERSIDE COUNTY TRANS. DEPT. PERMIT SECTION AT RIVERSIDE (714) 275-6790 AT LEAST 48 HOURS IN ADVANCE OF STARTING CONSTRUCTION.
- AT LEAST 48 HOURS PRIOR TO COMMENCING CONSTRUCTION, THE CONTRACTOR SHALL NOTIFY.

- LEE LAKE WATER DISTRICT 1 (714) 737-1719
- UNDERGROUND SERVICES ALERT (USA) 1 (800) 422-4133
- ALL PERMIT AGENCIES
- ALL OTHER AFFECTED UTILITIES;
 - SO. CALIF. GAS TRANSMISSION DIVISION (USA 1 (800) 422-4133)
 - SO. CALIF. GAS CO. AT RIVERSIDE (USA 1 (800) 422-4133)
 - SO. CALIF. Edison Co. (USA 1 (800) 422-4133)
 - PACIFIC TELEPHONE (USA) 1 (800) 422-4133
 - TEMECAL WATER COMPANY 1 (714) 277-0811
 - CITY OF CORONA 1 (714) 736-1205, DON WILLIAMS

• ALL VALVES 16" AND LARGER SHALL HAVE A VALVE BYPASS PER DETAIL, DWG. NO. 18



RECORD DRAWING
Date: 12/19/92 By: [Signature]
CAMP DRESSER & McKEE INC.

RECOMMENDED BY:
[Signature]
JSE
DATE: 12/19/92



APPROVED BY:
[Signature]
DISTRICT MANAGER
DATE: 10/19/92

Lee Lake Water District
PHASE 1B CONSTRUCTION

DESIGNED	CHECKED	DRAWN	DATE
RLV	KH/MT	C.L.P.	

DESIGNED	CHECKED	DRAWN	DATE
RLV	KH/MT	C.L.P.	

John S. W. mark engineers, Inc.
2770 El Camino Real
Carlsbad, California 92009
(619

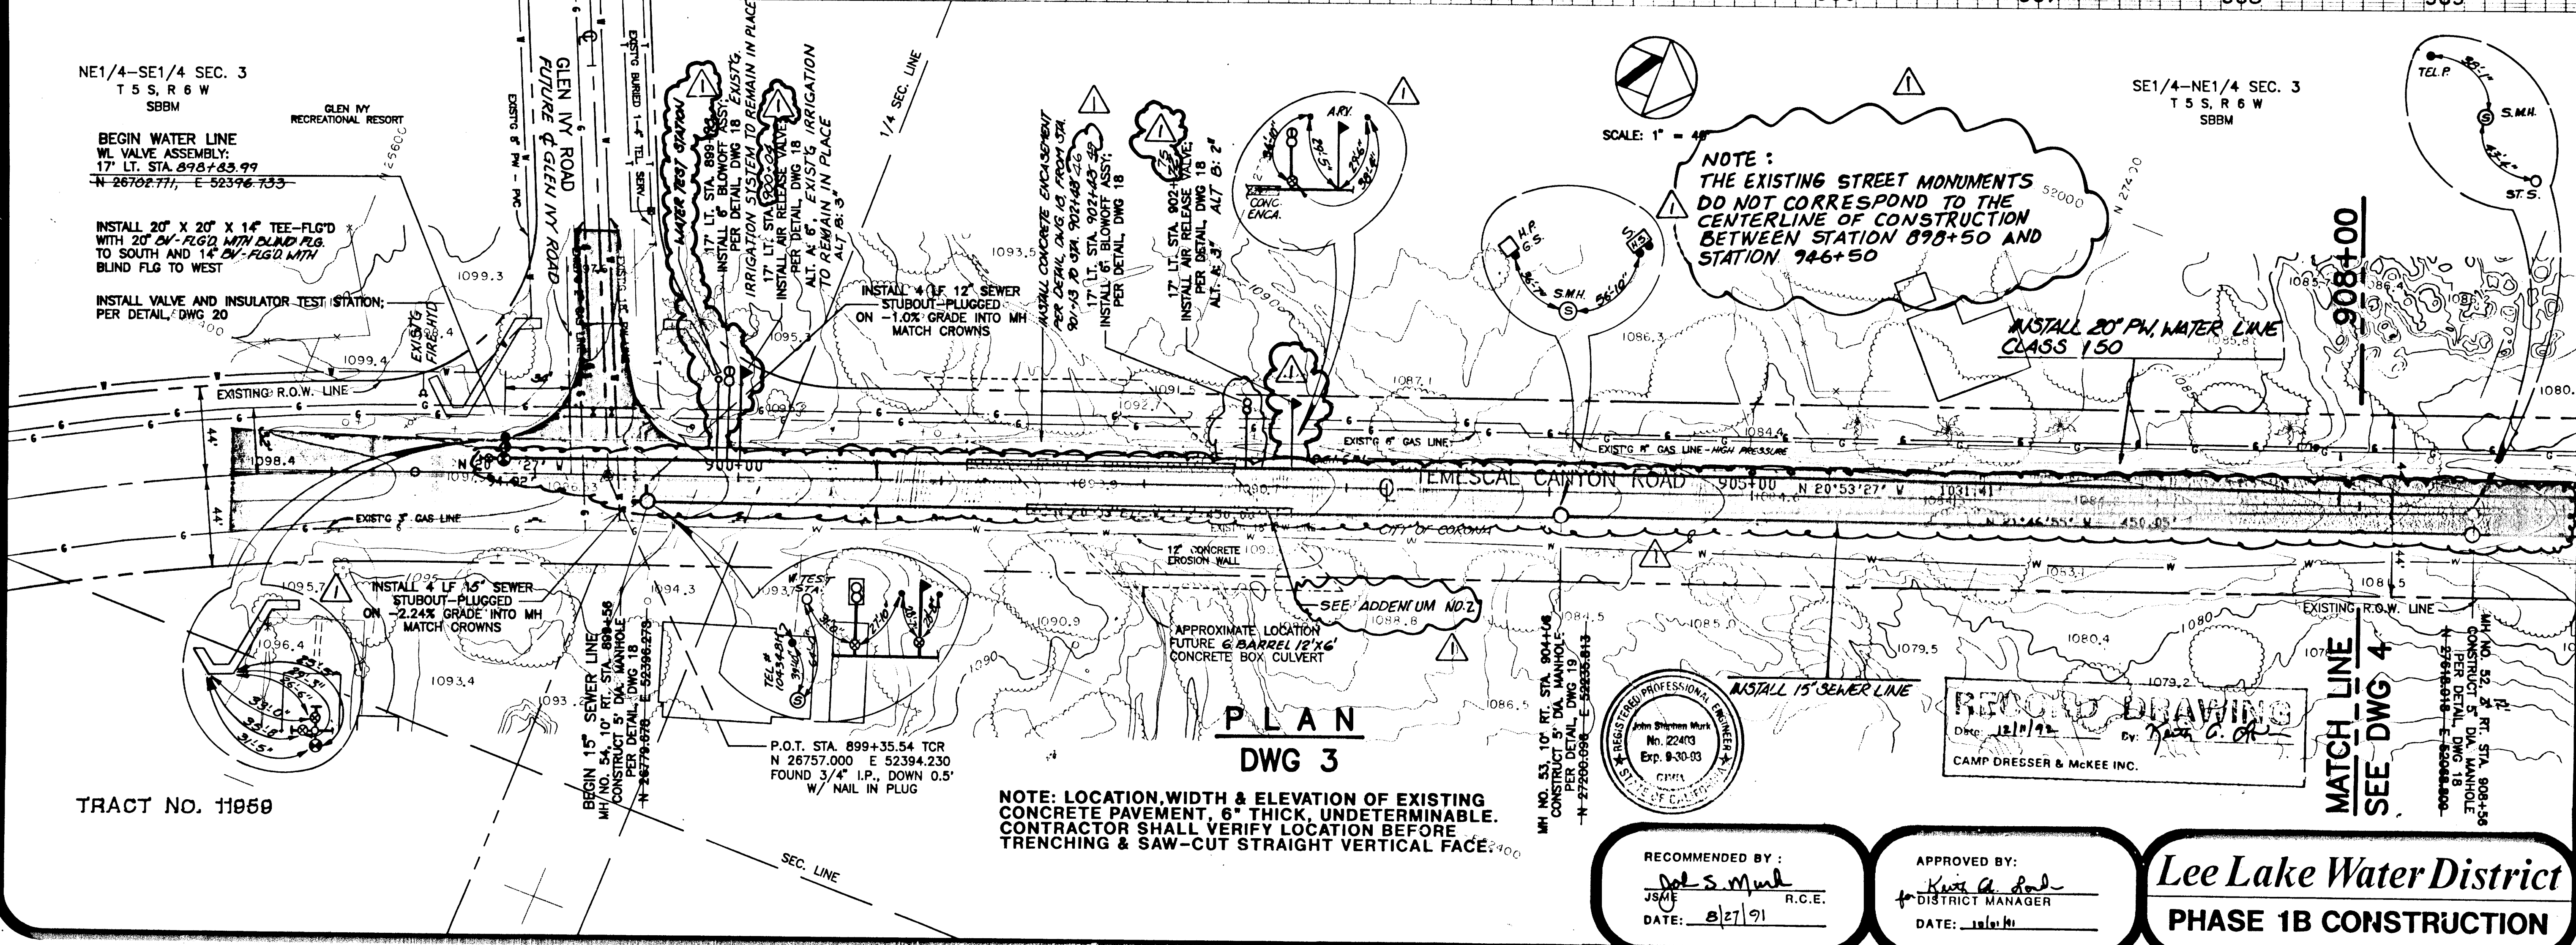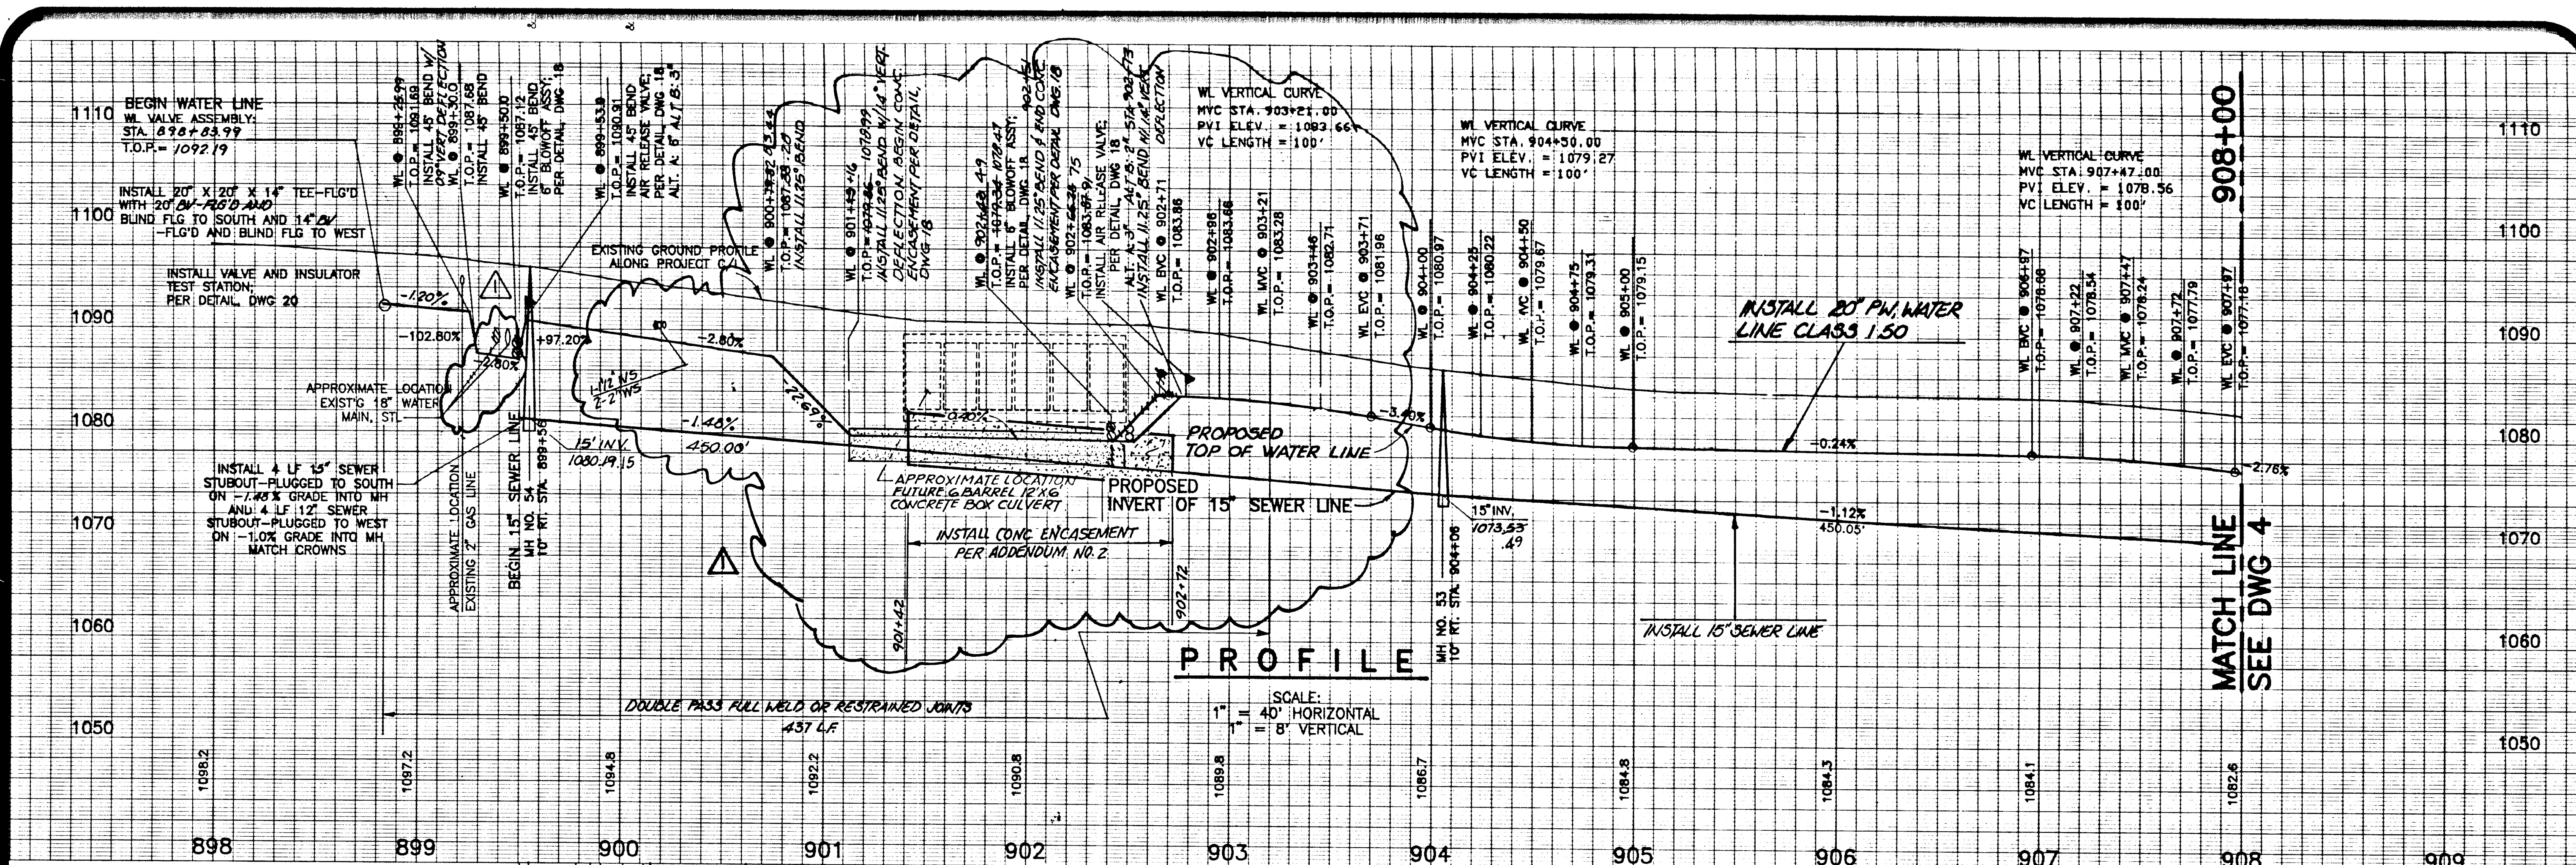

NO.	REVISIONS	DATE
1	AS BUILT	10-12-72
2	JC	INTALS

DESIGNED	VJ
CHECKED	ALV/JH
DRAWN	VJ
DATE	

JSM&E
John S. Mark Engineers, Inc.
7770 El Camino Real
Carlsbad, CA 92009-3506
(619) 942-2100

LEE LAKE WATER DISTRICT
**PLAN & PROFILE: TEMESCAL CANYON RD
WATER & SEWER LINES
STA. 899+15 TO STA. 908+00**



SCALE
AS SHOWN
SHEET NO. 3
OF 24 SHEETS
DWG. NO.
3

RECOMMENDED BY:
John S. Mark
JSM
DATE: 8/27/91

APPROVED BY:
Kurt A. Dahl
DISTRICT MANAGER
DATE: 10/10/91

Lee Lake Water District
PHASE 1B CONSTRUCTION

RECORD DRAWING
Date: 12/1/91
By: Kurt A. Dahl
CAMP DRESSER & MCKEE INC.

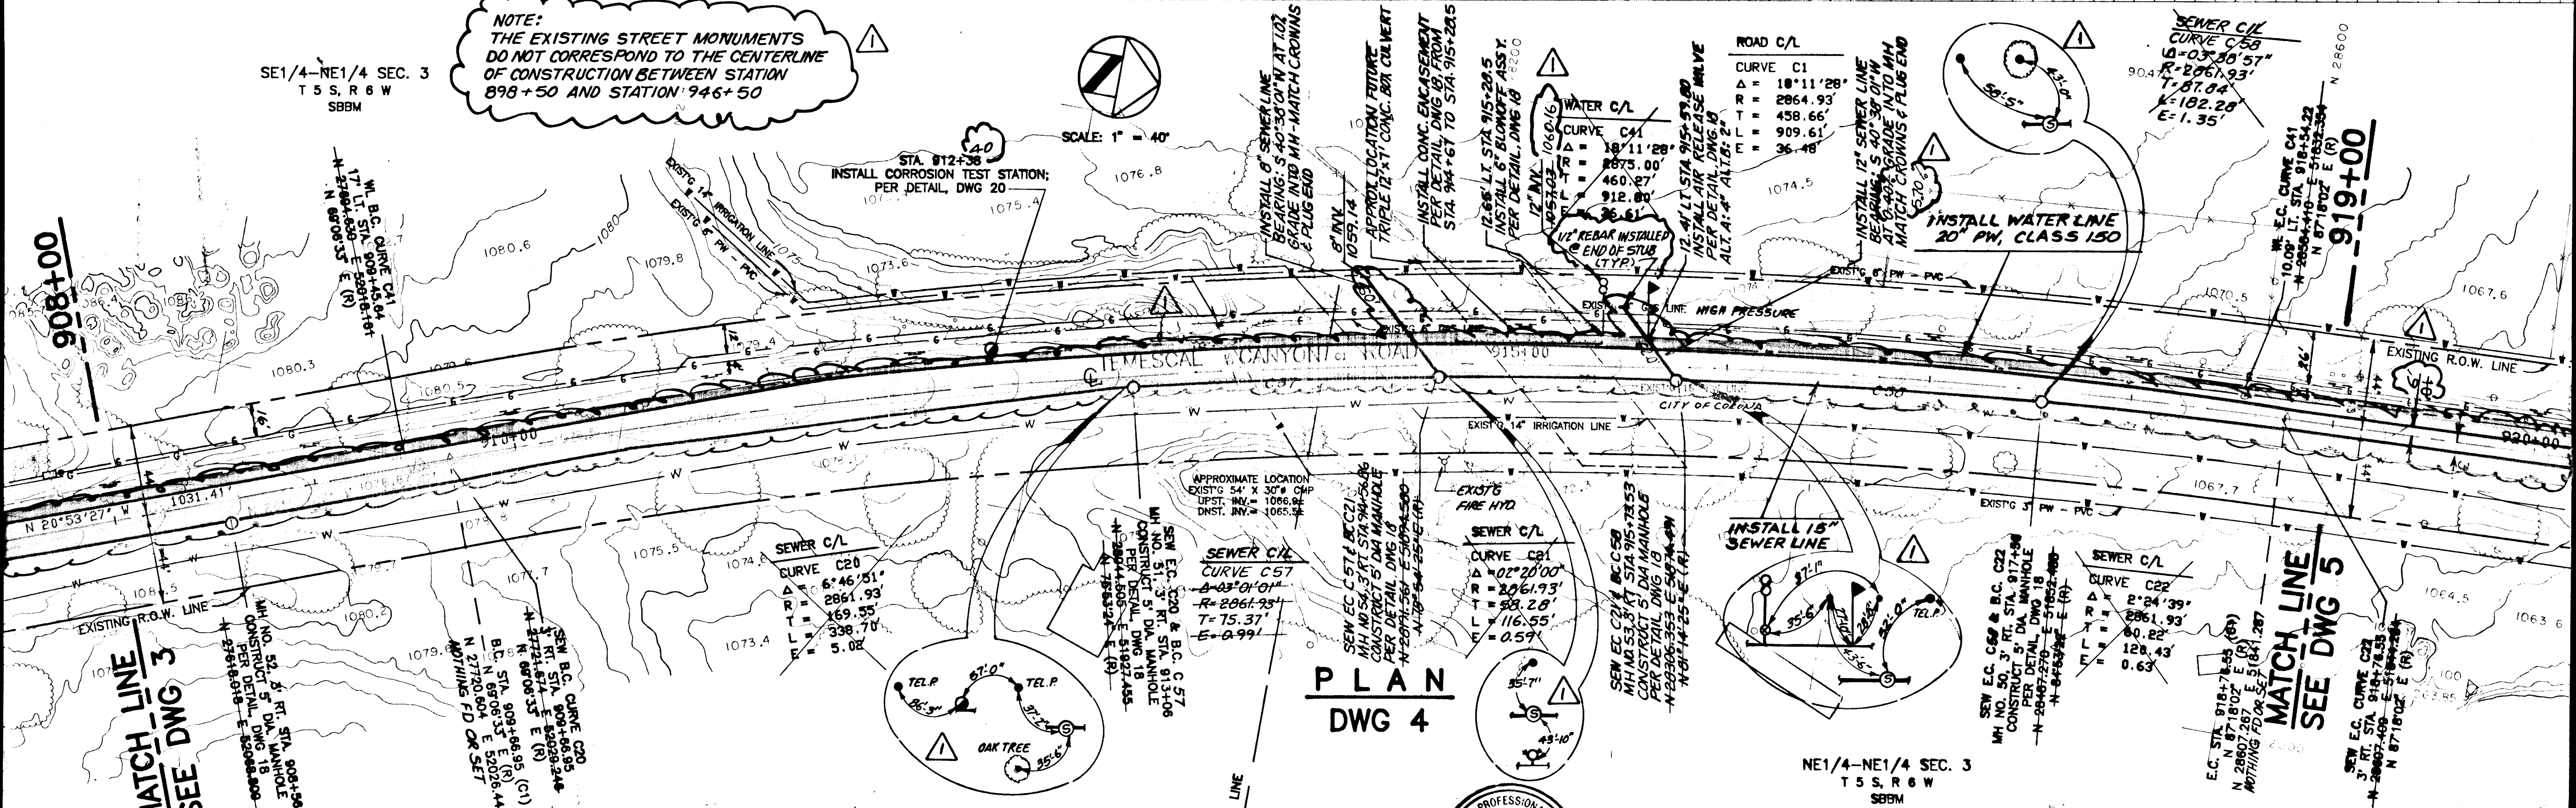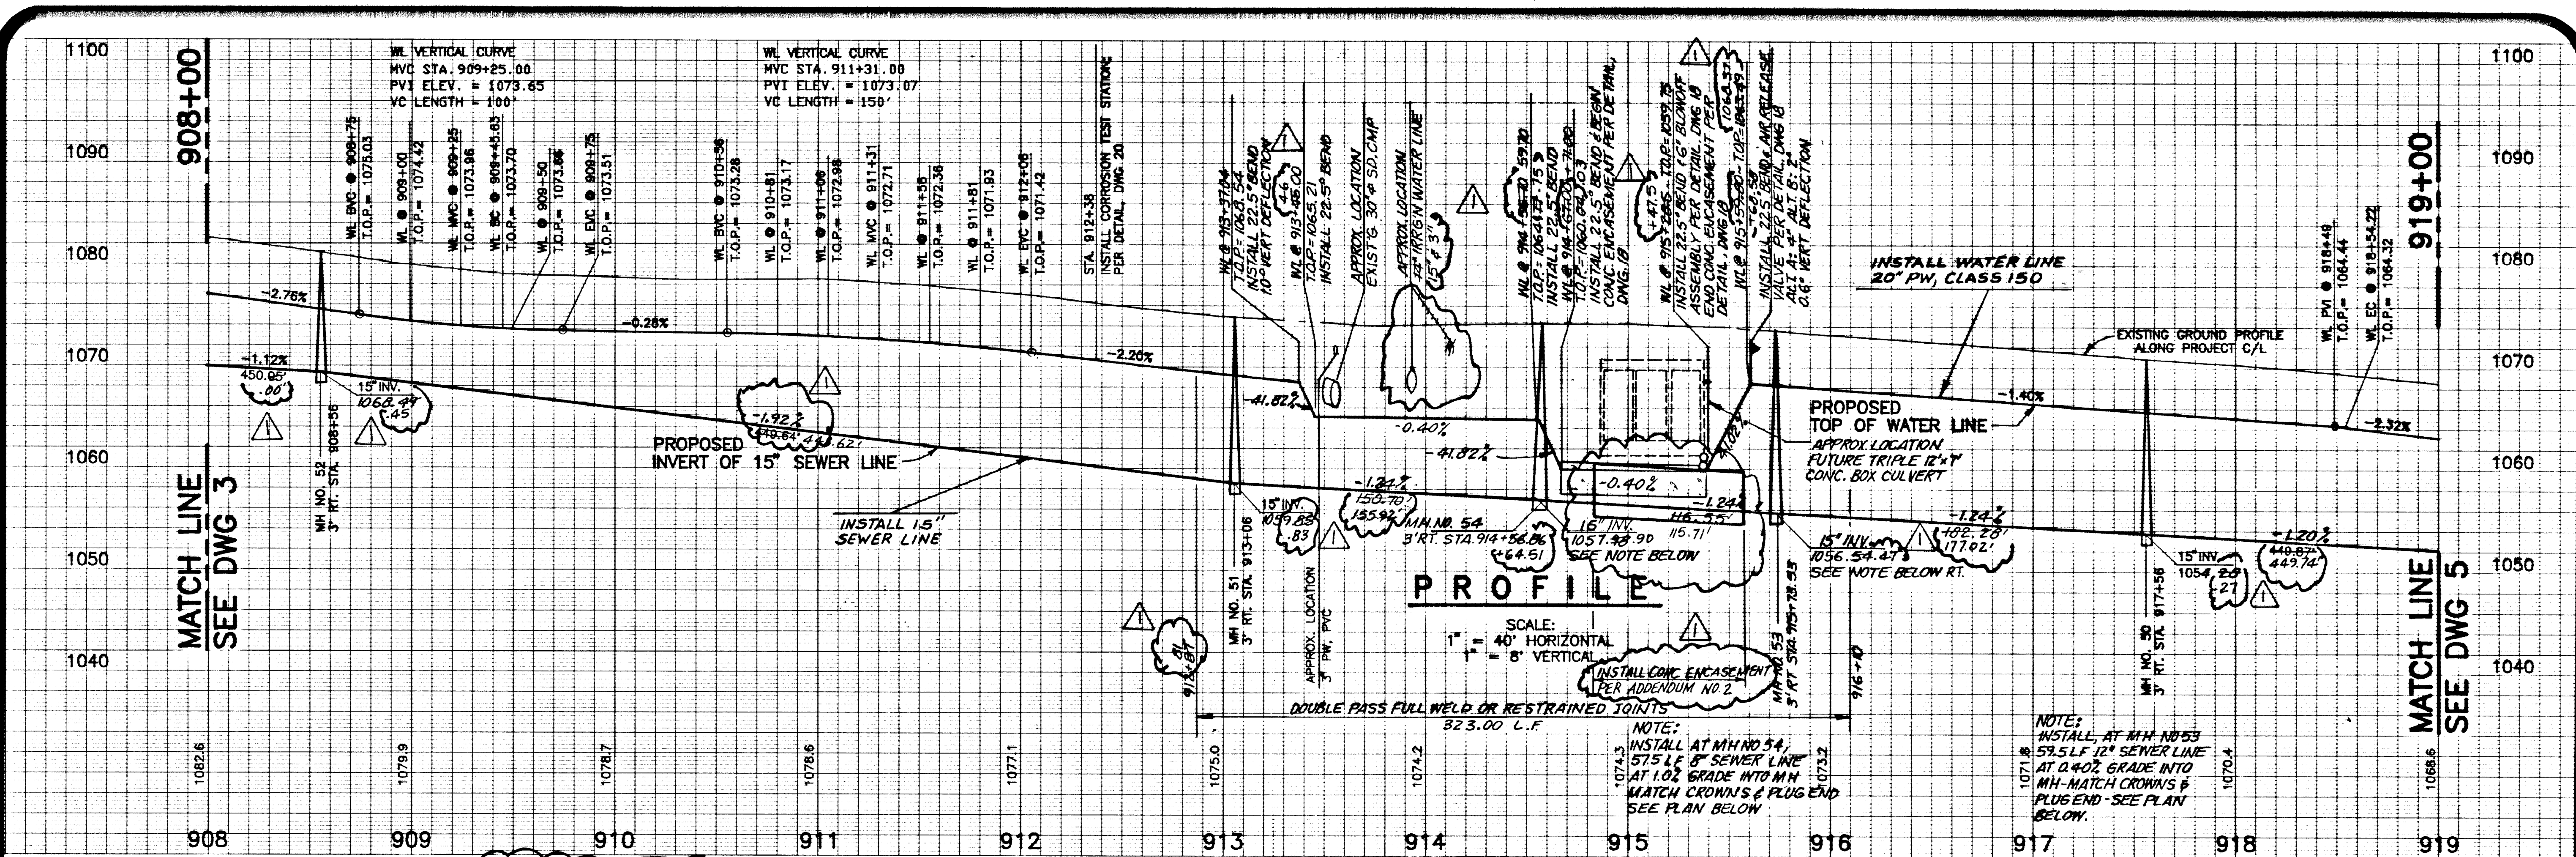

RECORD DRAWING
Date: 12/1/91 By: [Signature]
CAMP DRESSER & McKee INC.

NOTE: LOCATION, WIDTH & ELEVATION OF EXISTING CONCRETE PAVEMENT, 6" THICK, UNDETERMINABLE. CONTRACTOR SHALL VERIFY LOCATION BEFORE TRENCHING & SAW-CUT STRAIGHT VERTICAL FACE.

PLAN
DWG 4



RECOMMENDED BY:
[Signature]
JSM/E R.C.E.
DATE: 8/27/91

APPROVED BY:
[Signature]
DISTRICT MANAGER
DATE: 10/1/91

Lee Lake Water District
PHASE 1B CONSTRUCTION

PLAN & PROFILE: TEMESCAL CANYON RD.
WATER & SEWER LINES
STA. 908+00 TO 919+00

LEE LAKE WATER DISTRICT



JSM/E

John S. Mura Engineers, Inc.
7770 El Camino Real
Carlsbad, CA 92009-2506
(619) 942-2100

DESIGNED
VJ
CHECKED
RLV/JH
DRAWN
VJ
DATE

NO. AS BUILT
REVISIONS
J.C. 10/2/92
DATE

SCALE
AS SHOWN
SHEET NO. 4
OF 24 SHEETS
DWG. NO. 4

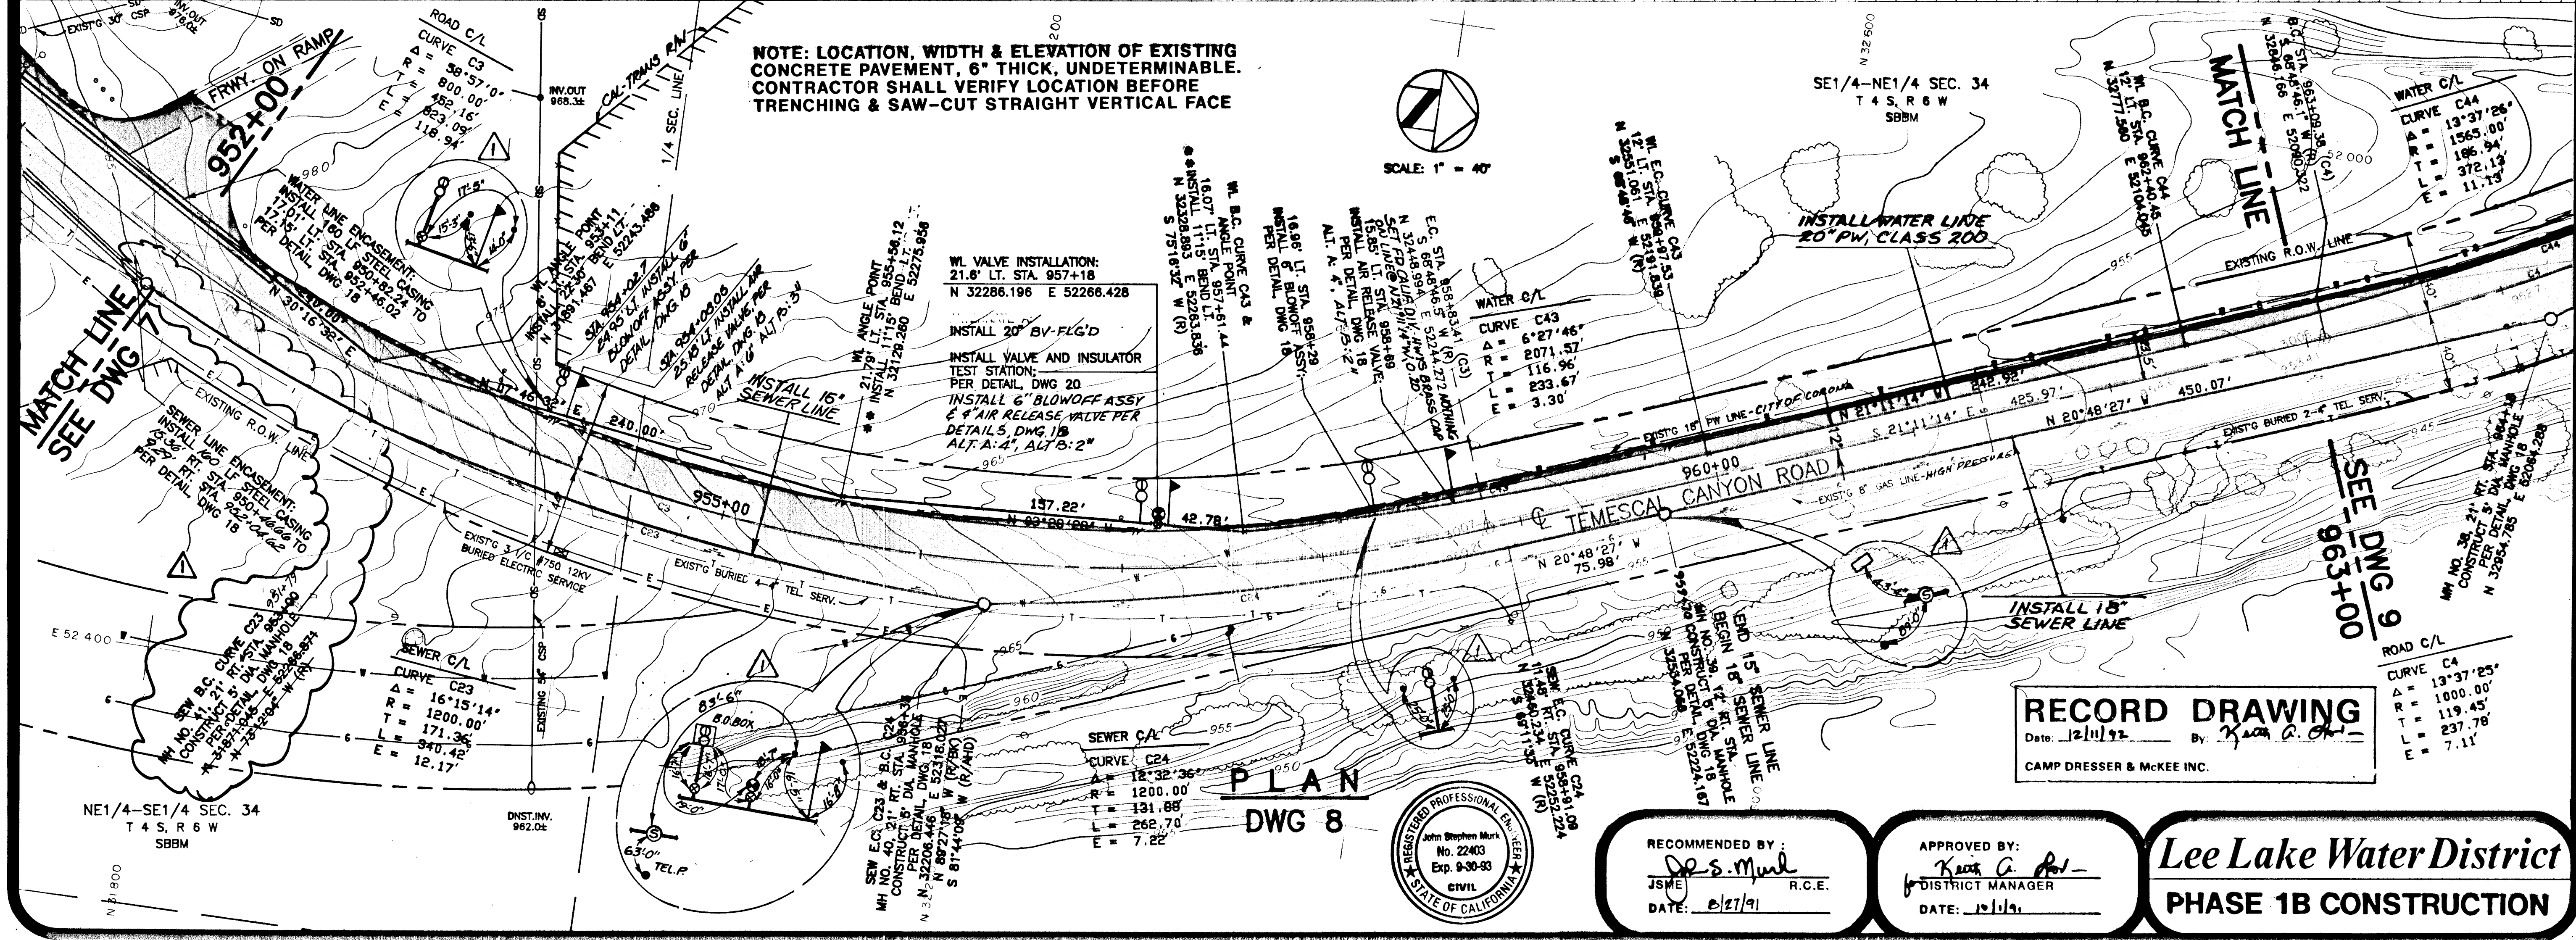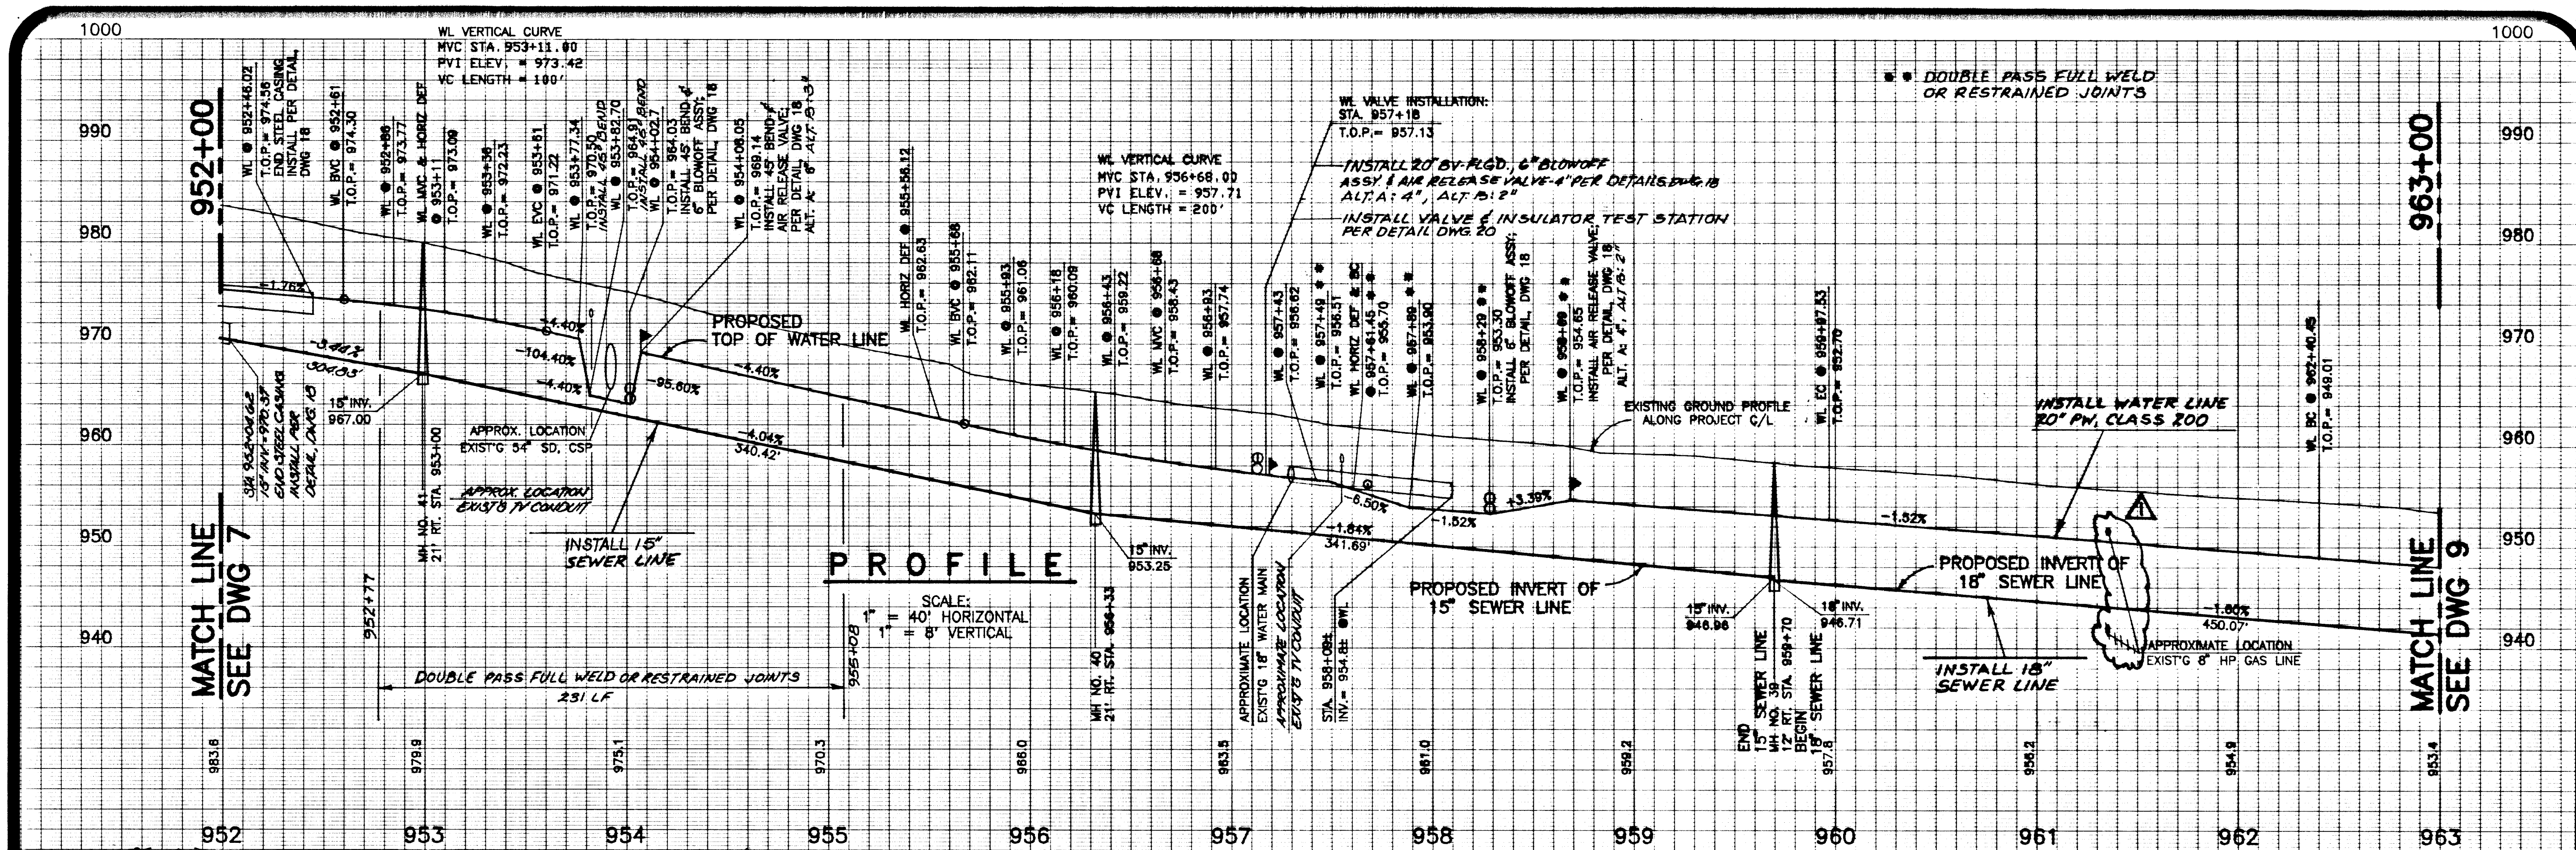

RECORD DRAWING
 Date: 12/11/92 By: [Signature]
 CAMP DRESSER & MCKEE INC.

RECOMMENDED BY:
 [Signature] J.S.M. R.C.E.
 DATE: 12/27/91

APPROVED BY:
 [Signature] DISTRICT MANAGER
 DATE: 12/11/92

Lee Lake Water District
PHASE 1B CONSTRUCTION

DESIGNED
V.J.

CHECKED
R.V./J.H.

DRAWN
V.J.

DATE
12/27/91

NO.
15

REVISIONS



INITIALS
J.C.

DATE
12/27/91

PLAN & PROFILE: TEMESCAL CANYON RD
WATER & SEWER LINES
STA. 952+00 TO STA. 963+00

Lee Lake Water District
PHASE 1B CONSTRUCTION

SCALE
 AS SHOWN
 SHEET NO. 8
 OF 24 SHEETS
 DWG. NO. 8

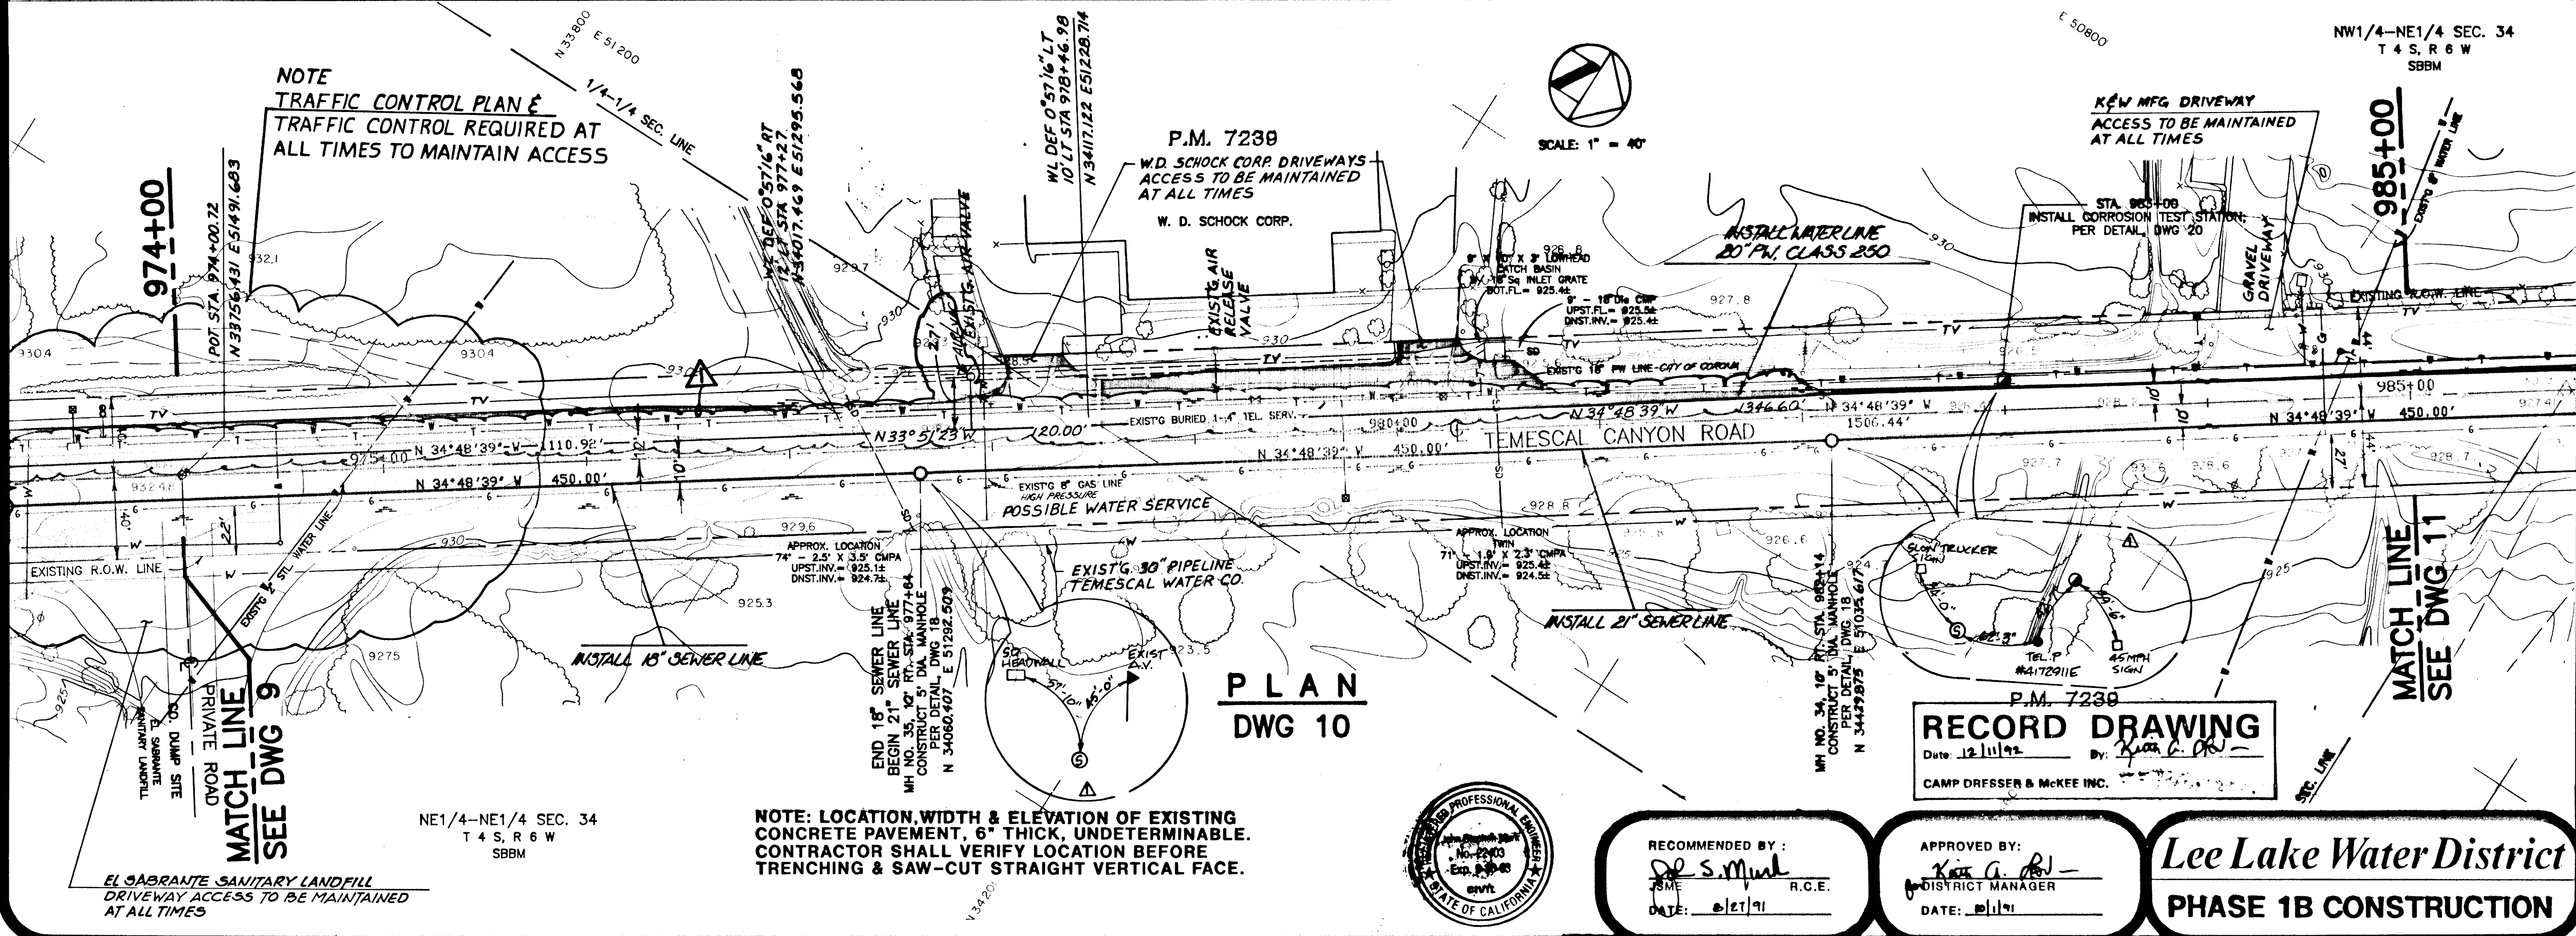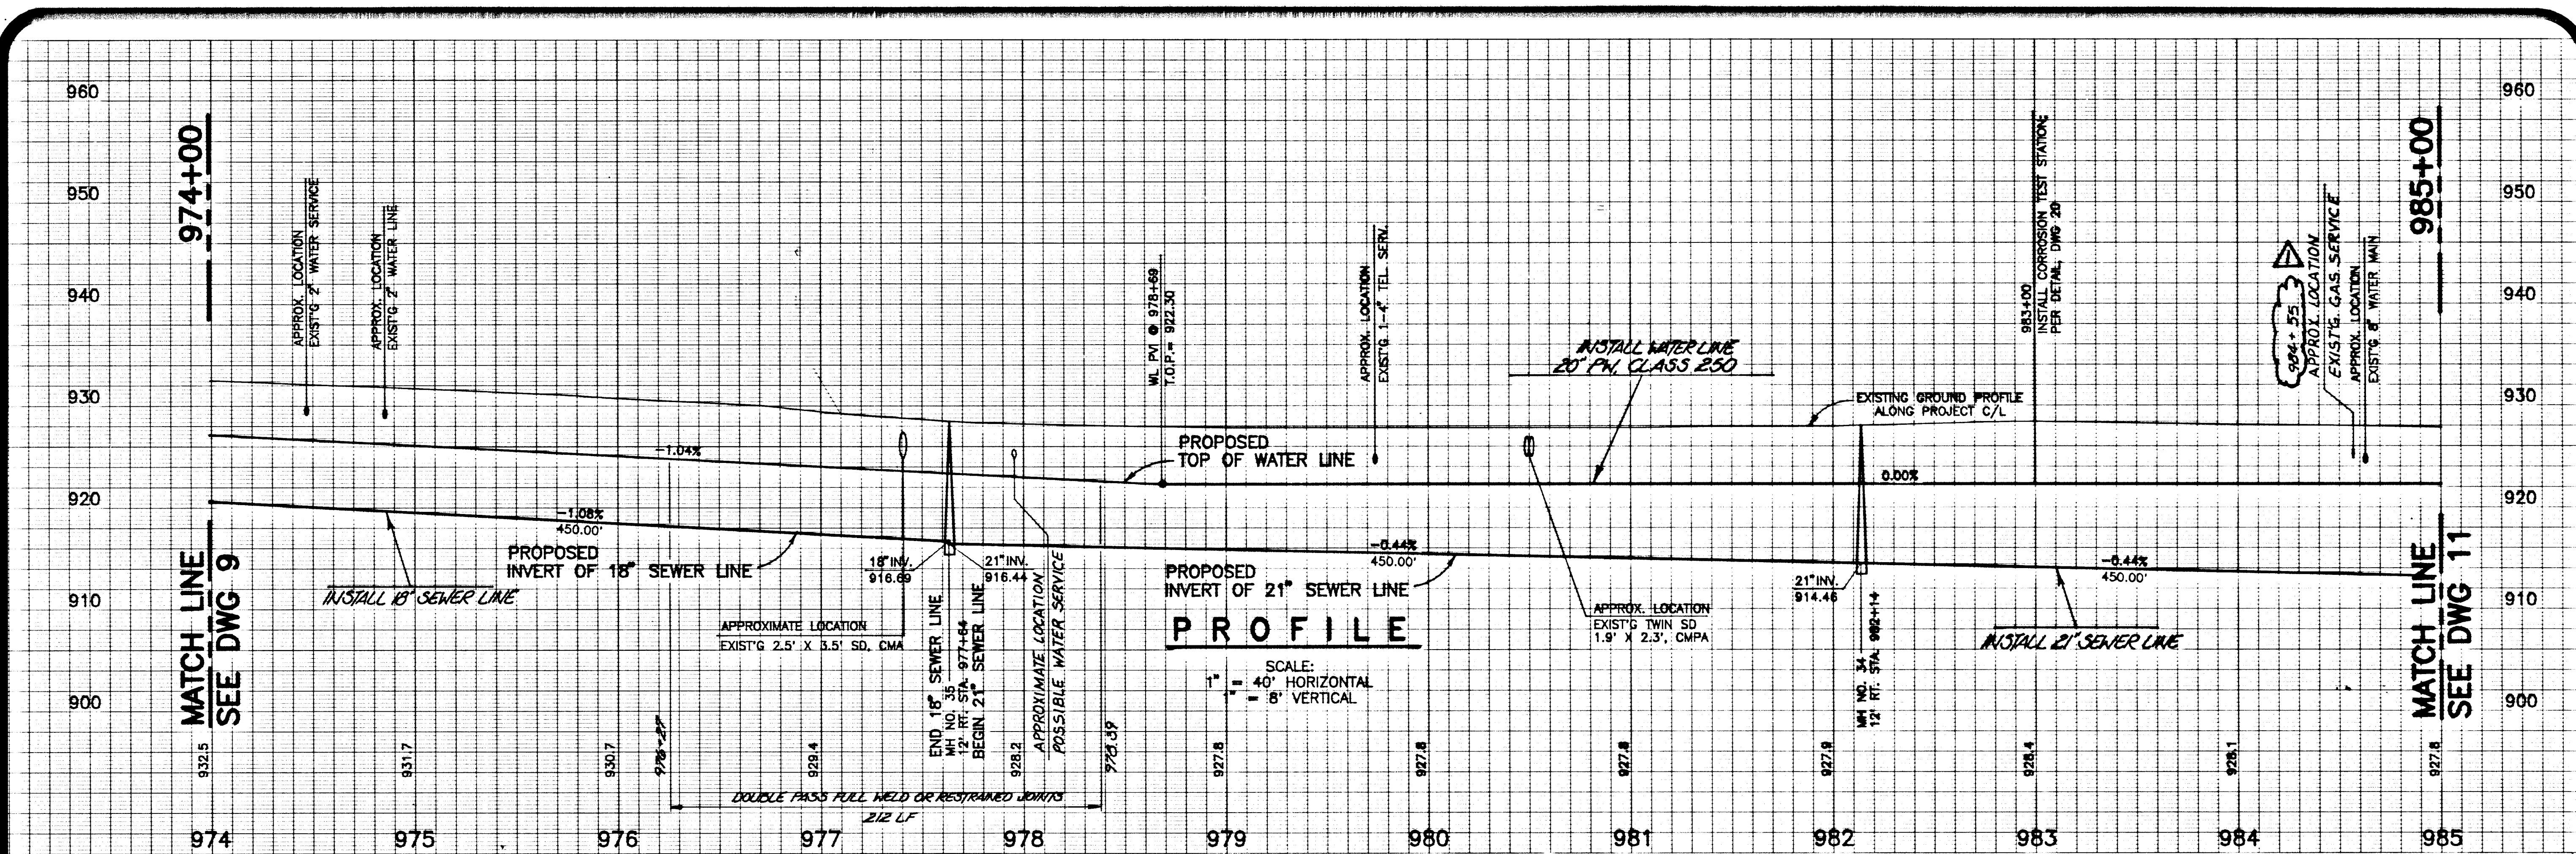

RECOMMENDED BY:
S. M. M.
DATE: 6/27/91

APPROVED BY:
K. A. R.
DISTRICT MANAGER
DATE: 6/11/91

Lee Lake Water District
PHASE 1B CONSTRUCTION

NO.	REVISIONS	INITIALS	DATE
1	AS-BUILT	ELU	10-12-92

DESIGNED	CHECKED	DATE
VJ	RLV/JH	
DRAWN	VJ	


JSA&E
John S. Mark Engineers, Inc.
7770 El Camino Real
Carlsbad, CA 92009-2506
(619) 942-2100

PLAN & PROFILE: TEMESCAL CANYON RD
WATER & SEWER LINES
STA. 974+00 TO STA. 985+00

SCALE
AS SHOWN
SHEET NO. 10
OF 24 SHEETS
DWG. NO.
10



WATER C/L
CURVE C55
 $\Delta = 2^{\circ}59'50''$
 $R = 1565.00$
 $T = 40.94$
 $L = 81.87$
 $E = 0.54$

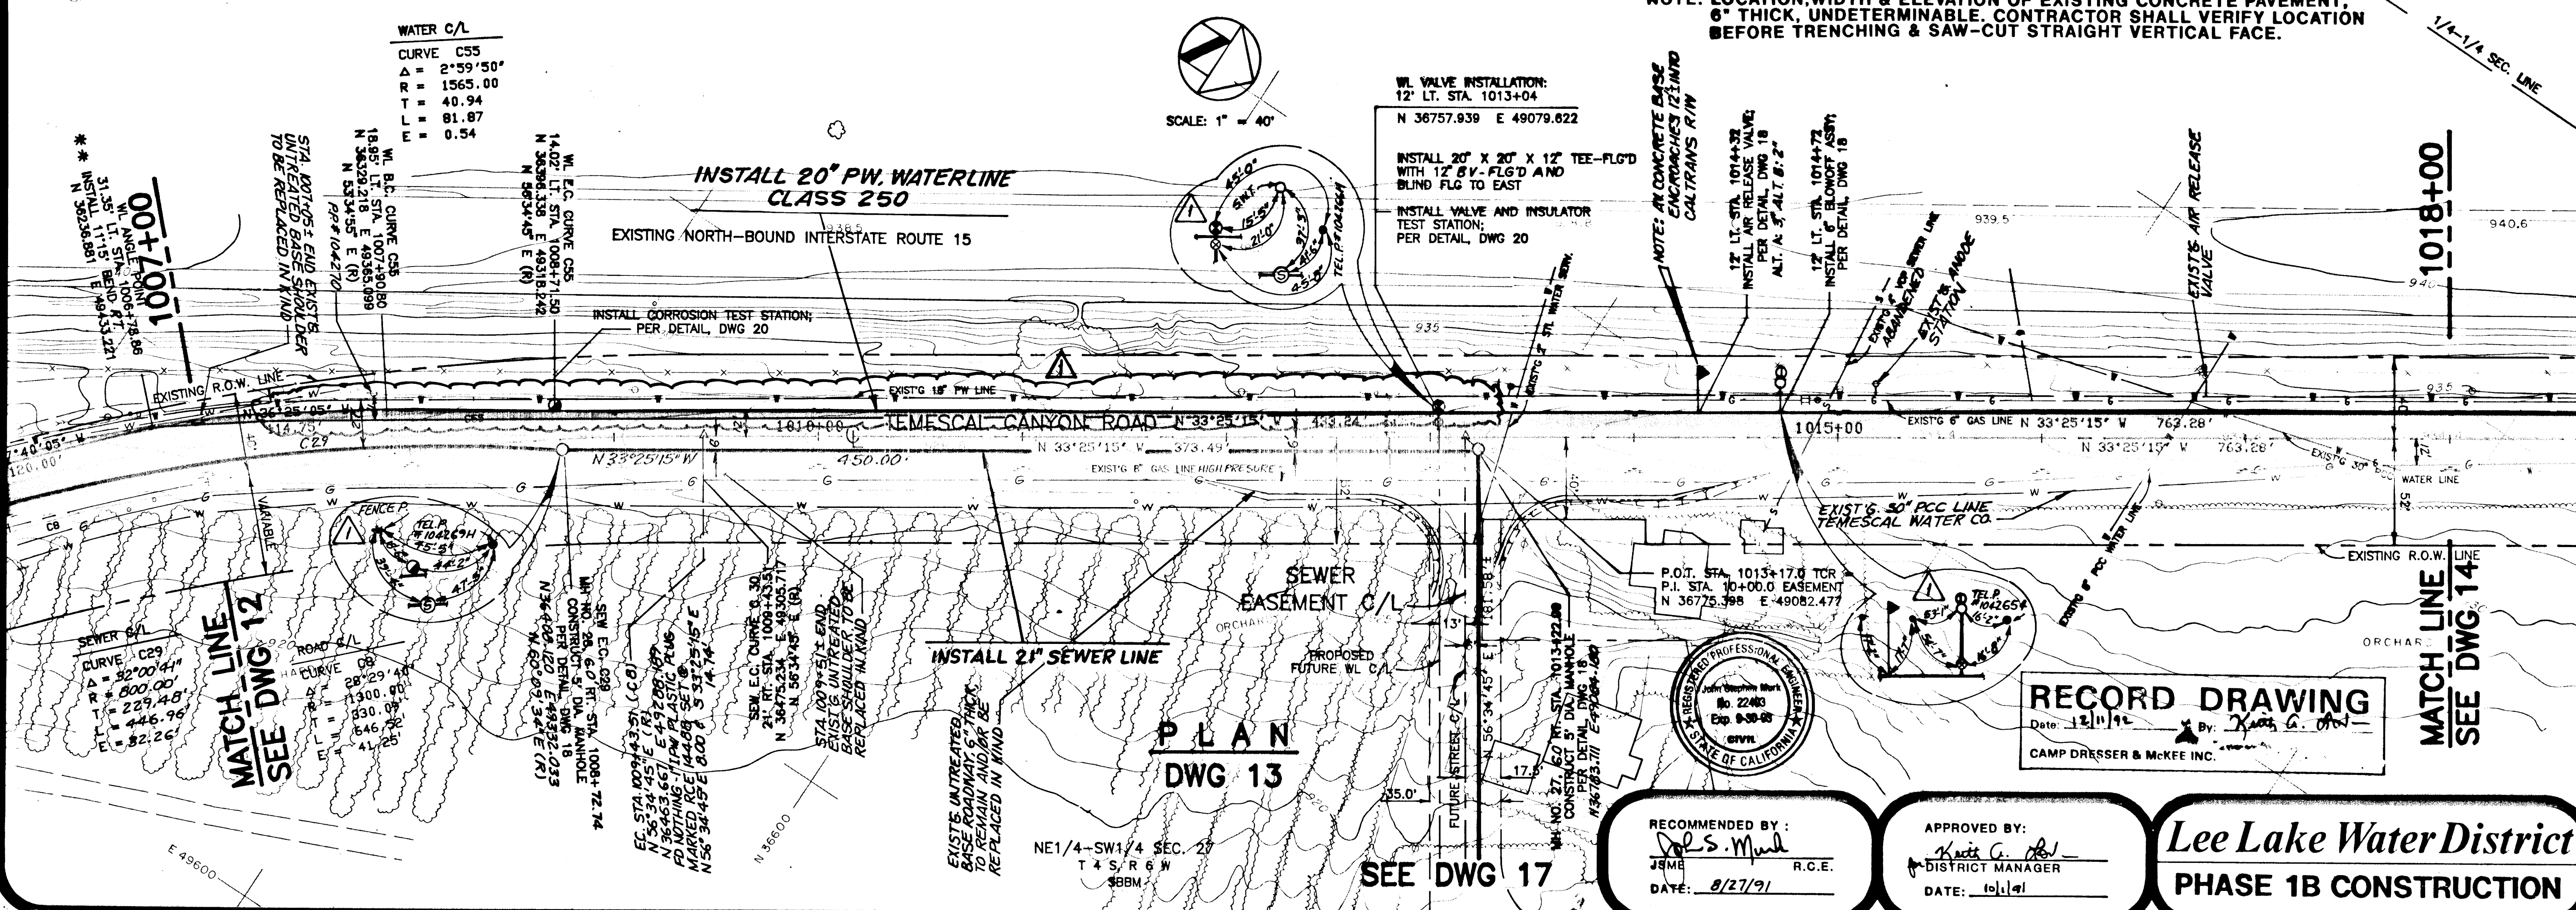

RECORD DRAWING
Date: 12/11/92 By: Keith G. Dow
CAMP DRESSER & McKEE INC.

RECOMMENDED BY : John S. Munk
JSM R.C.E.
DATE: 8/27/91

APPROVED BY:
Kath G. Sol
DISTRICT MANAGER
DATE: 10/1/91

Lee Lake Water District
PHASE 1B CONSTRUCTION

[illegible]



DESIGNED	JV
CHECKED	RLV/JH
DRAWN	JV
DATE	

JSAI E
John S. Mark engineers, inc.
2770 El Camino Real
Carlsbad, C.A. 92009-2504
(619) 942-2100

LEE LAKE WATER DISTRICT

**PLAN & PROFILE: TEMESCAL CANYON RD.
WATER & SEWER LINES
STA. 1007+00 TO STA. 1018+00**

SCALE
AS SHOWN
SHEET NO. 13
OF 24 SHEETS
DWG. NO.
13

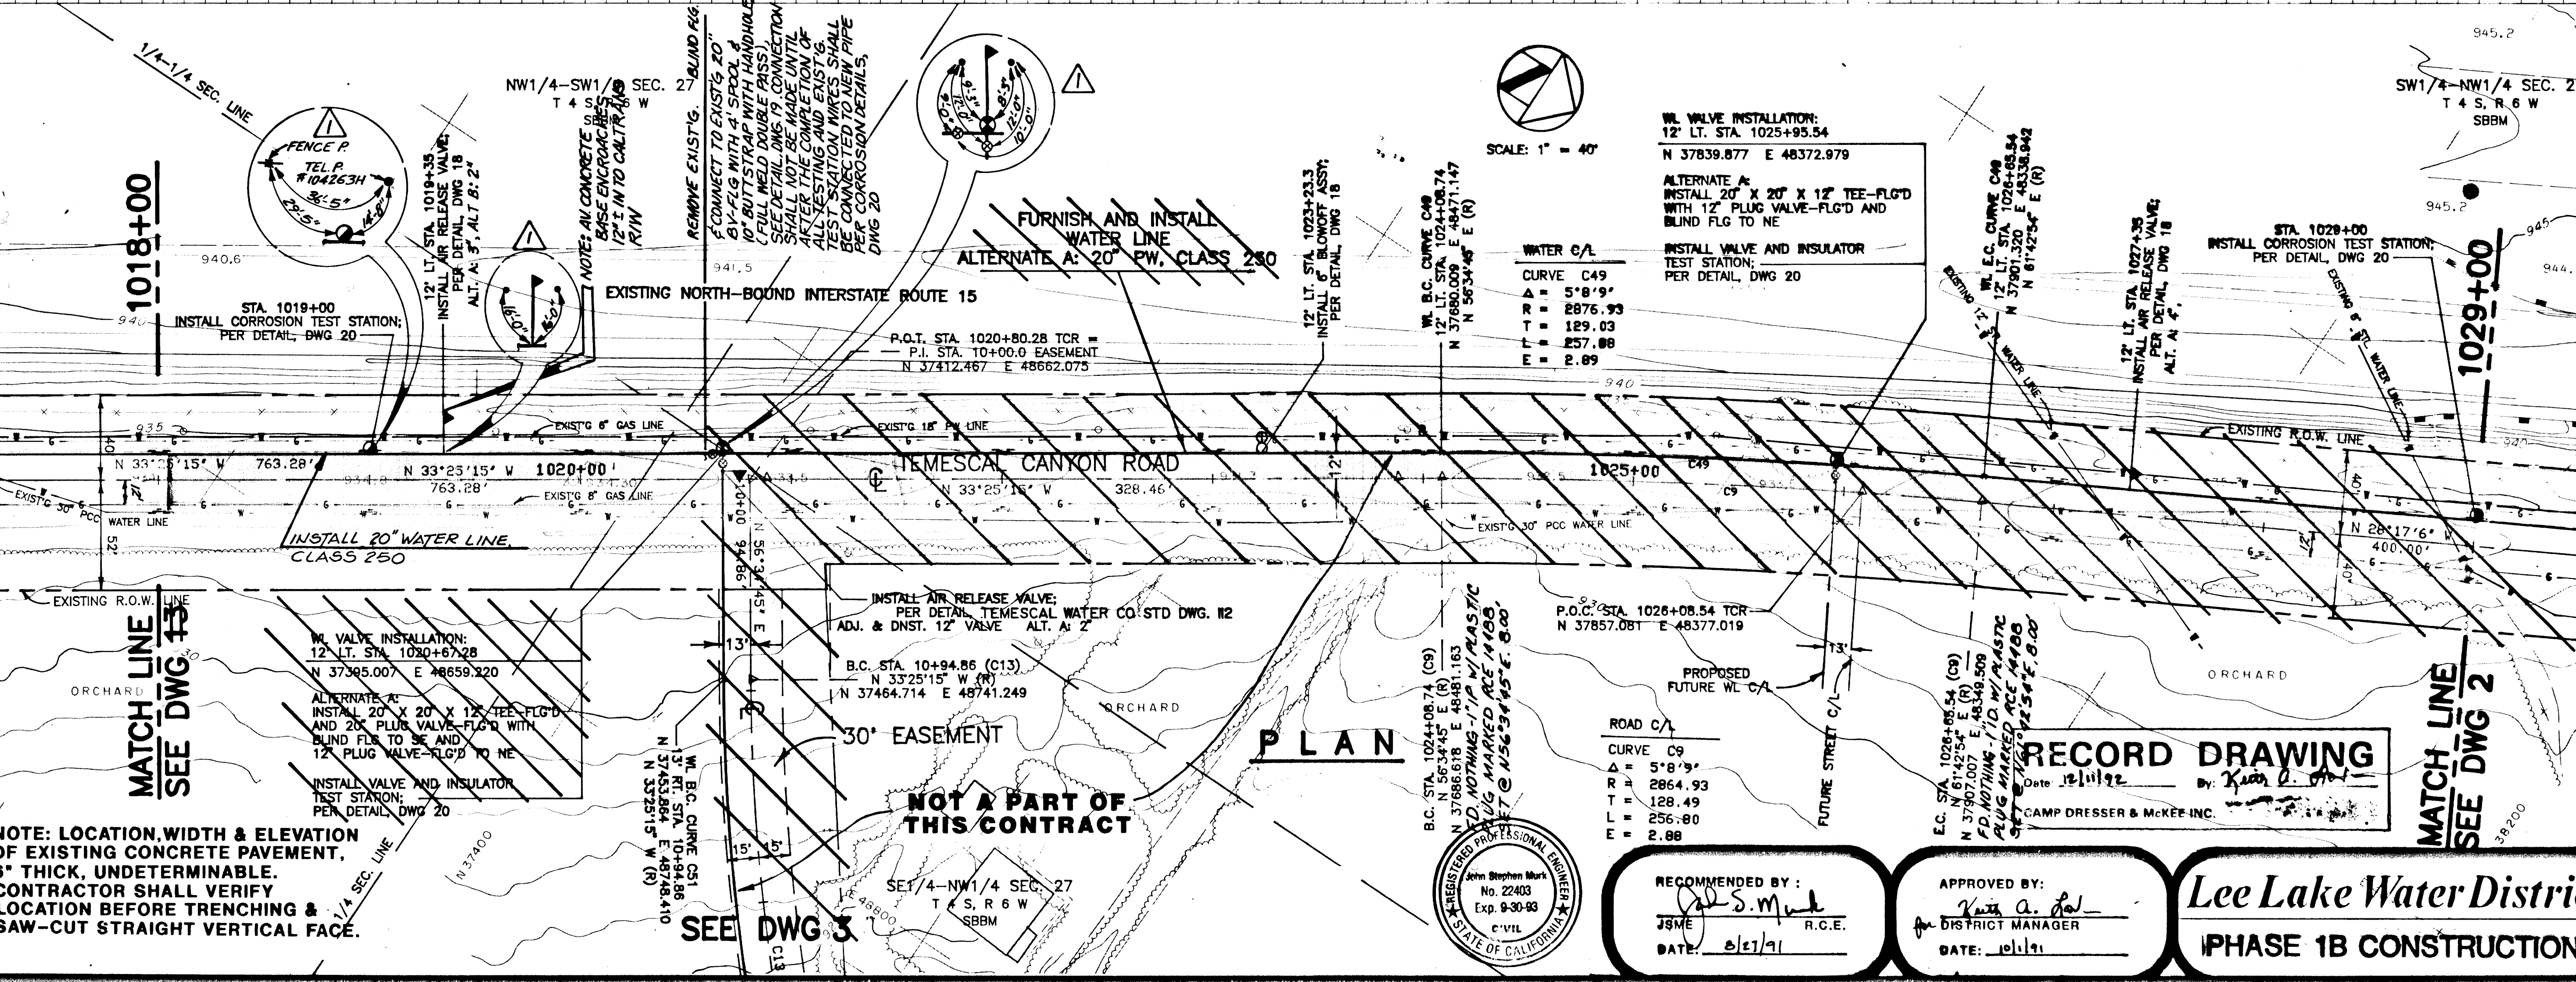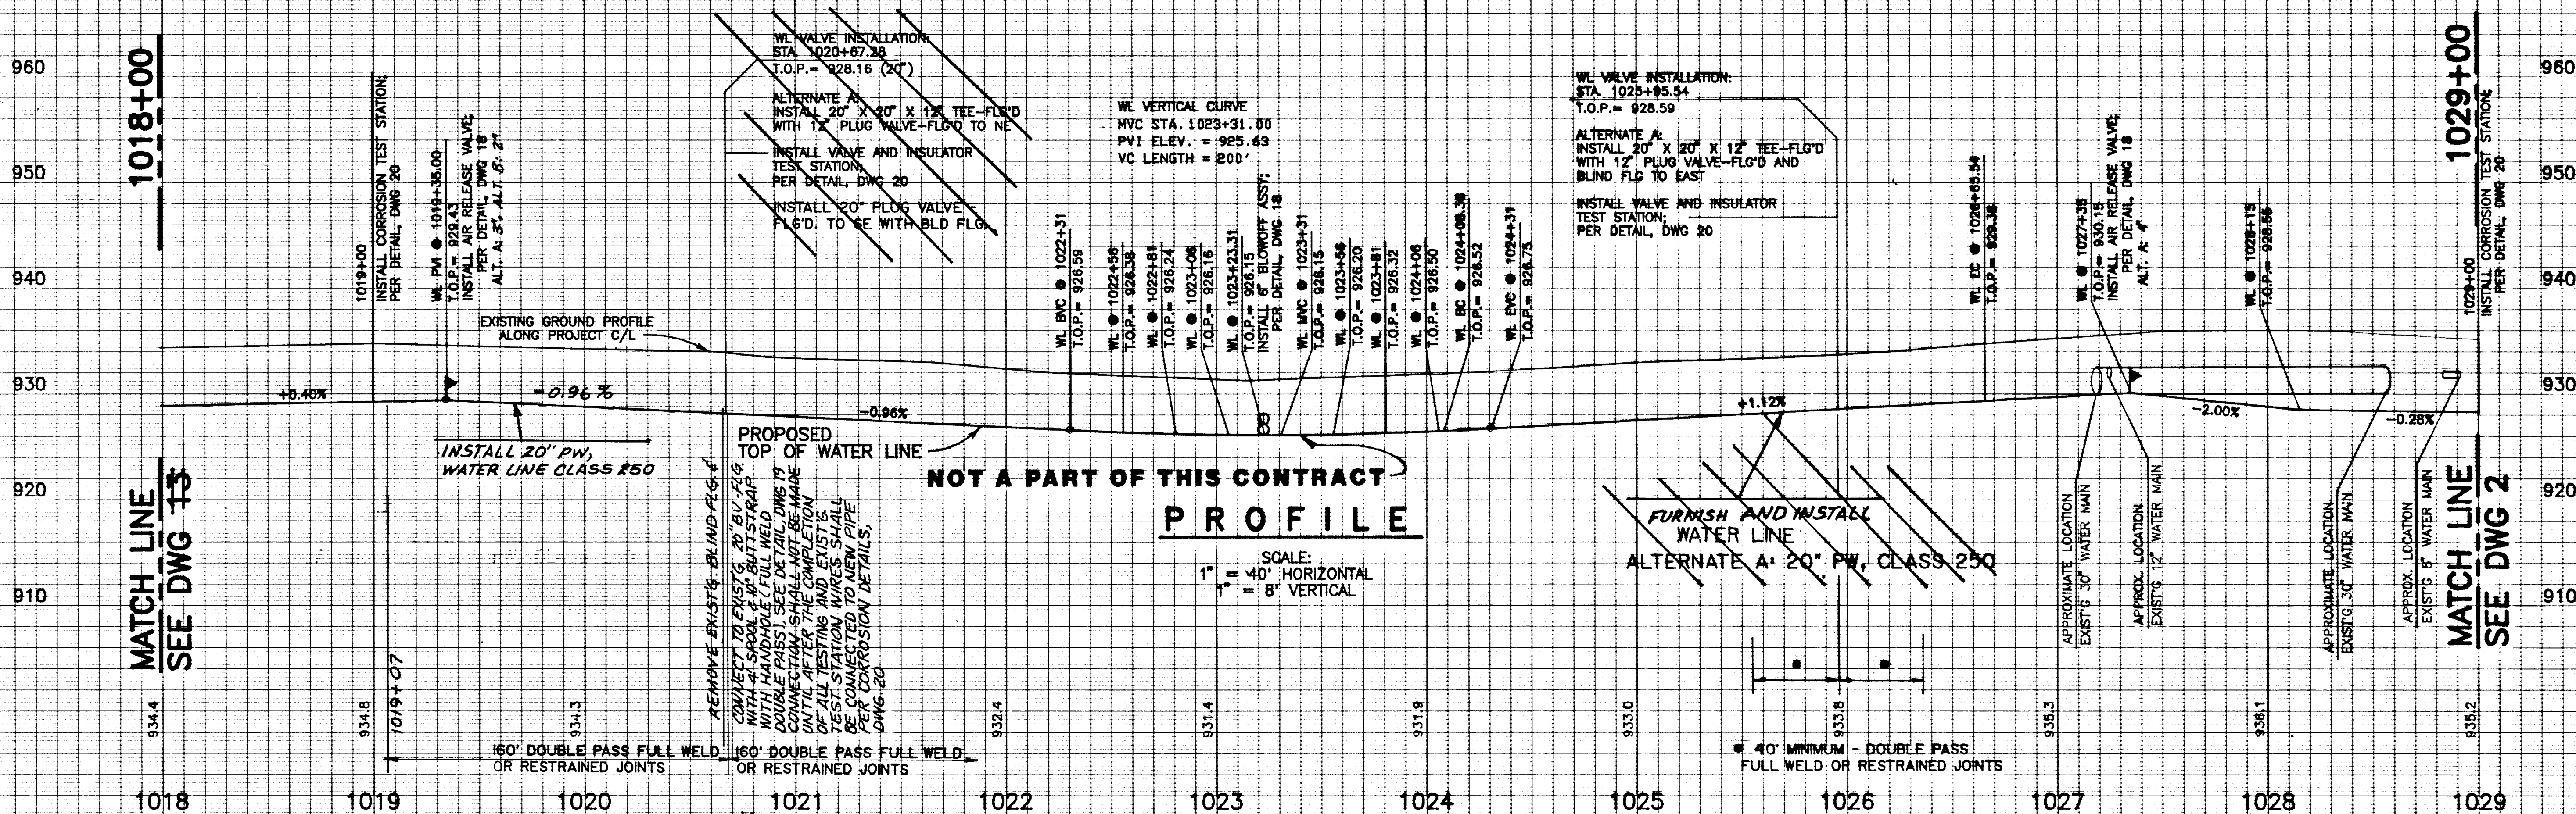

NO.	REVISIONS	DATE	INITIALS
1	AS BUILT	01-10-91	JC
2			
3			
4			
5			
6			
7			
8			
9			
10			

DESIGNED	VJ
CHECKED	RLV
DRAWN	VJ
DATE	01-10-91

JSAE
John S. Mark Engineers, Inc.
 7770 El Camino Real
 Carlsbad, CA 92009-8506
 (619) 943-2100



LEE LAKE WATER DISTRICT
 PLAN & PROFILE
 TEMESCAL CANYON ROAD WATER LINE
 STA 1018+00 TO STA 1020+67.28

SCALE
 AS SHOWN
 SHEET NO. 14
 OF 24 SHEETS
 DWG. NO.
 14

RECOMMENDED BY:
 JSM
 DATE: 8/2/91

APPROVED BY:
 K.A. [Signature]
 DISTRICT MANAGER
 DATE: 10/1/91

Lee Lake Water District
 PHASE 1B CONSTRUCTION

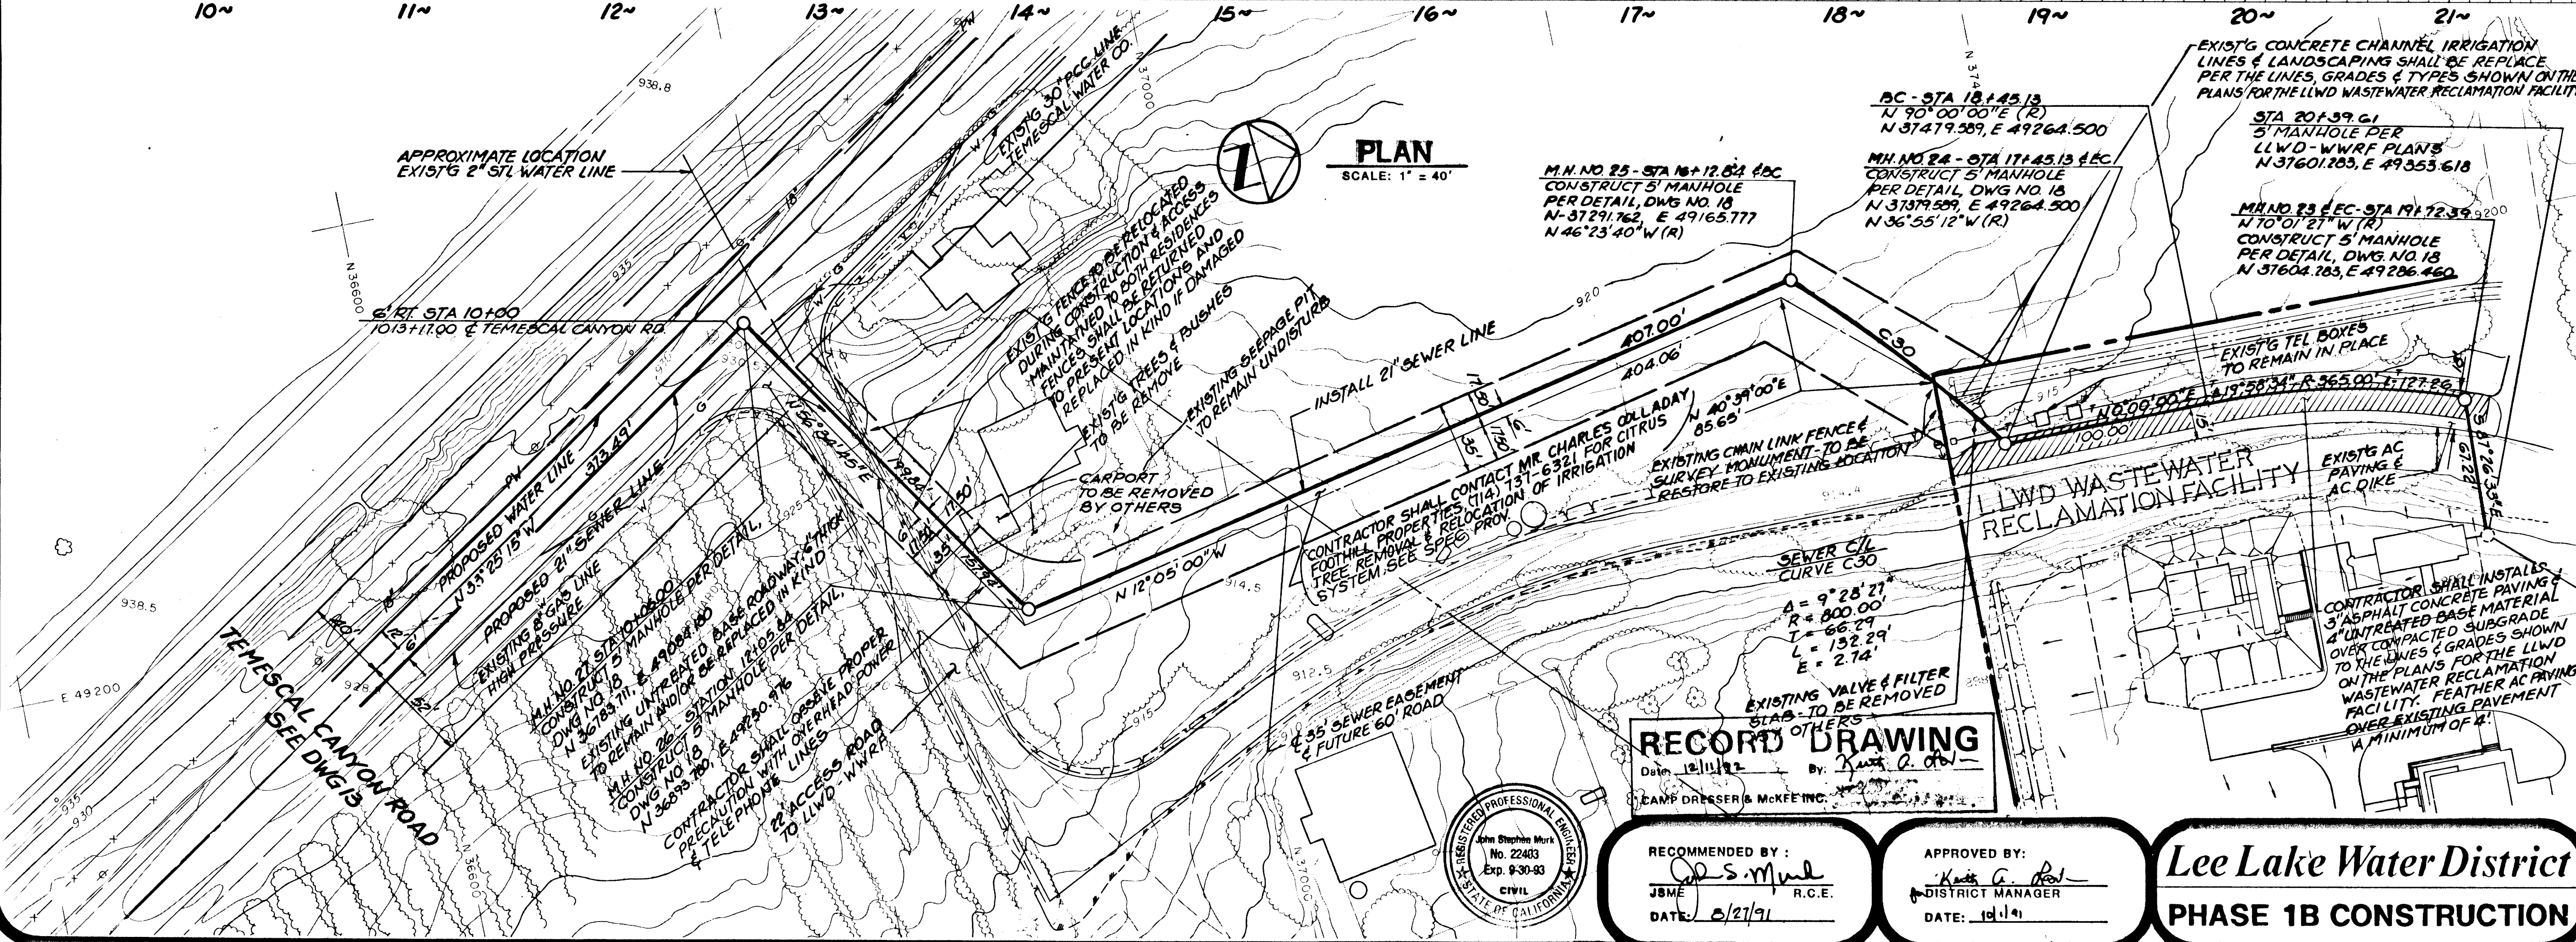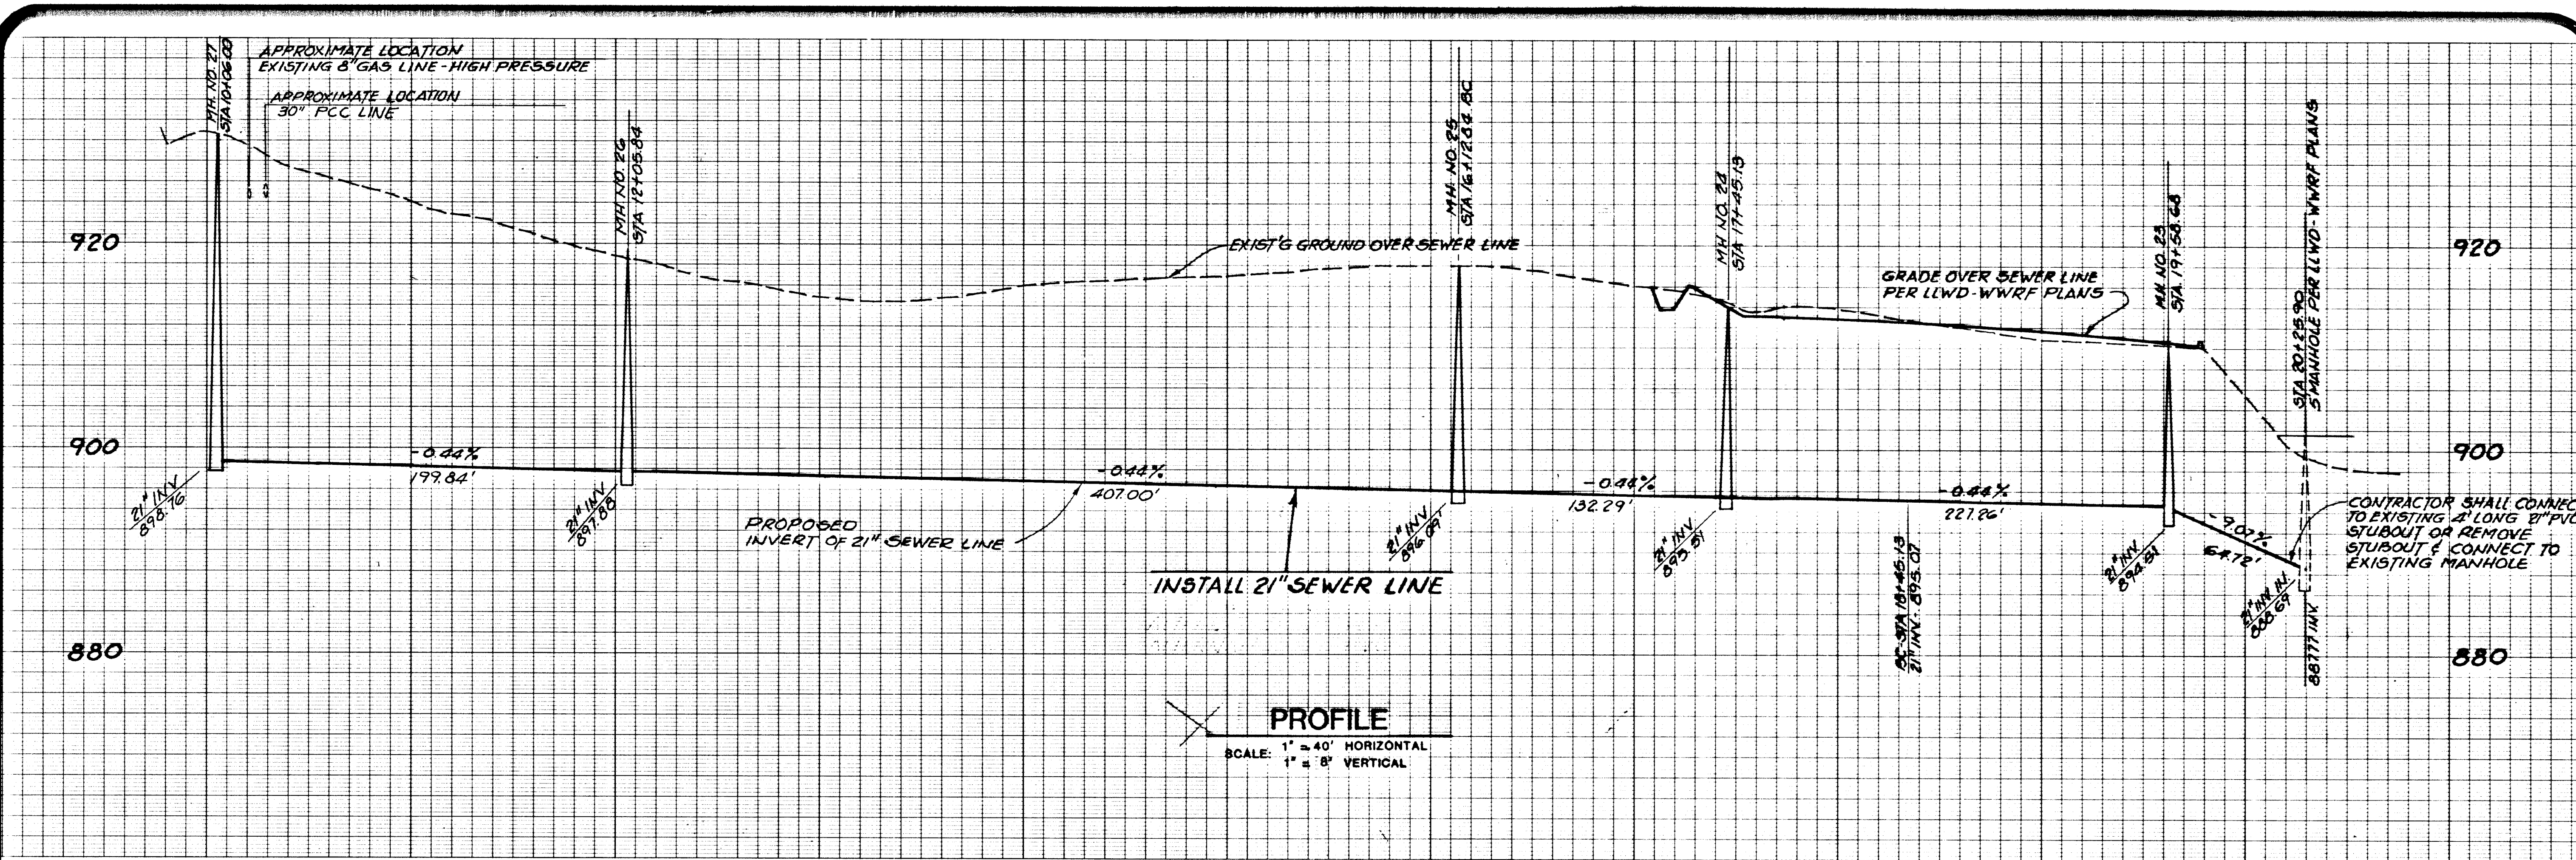

NO.	REVISIONS	INITIALS	DATE

DESIGNED	BY	DATE
CHECKED	BY	DATE
DRAWN	BY	DATE
DATE	7-24-91	

JSME
John S. Mark engineers, Inc.
 7770 El Camino Real
 Carlsbad, CA 92009-8506
 (619) 942-2100


LEE LAKE WATER DISTRICT
PLAN & PROFILE
21" SEWER TRUNK LINE
STA. 10+06 TO STA. 20+39.61

SCALE	AS NOTED
SHEET NO.	17
OF 24 SHEETS	
DWG. NO.	17

RECOMMENDED BY:
John S. Mark
 JSME R.C.E.
 DATE: 8/27/91

APPROVED BY:
Kevin G. Paul
 DISTRICT MANAGER
 DATE: 10/1/91

Lee Lake Water District
PHASE 1B CONSTRUCTION

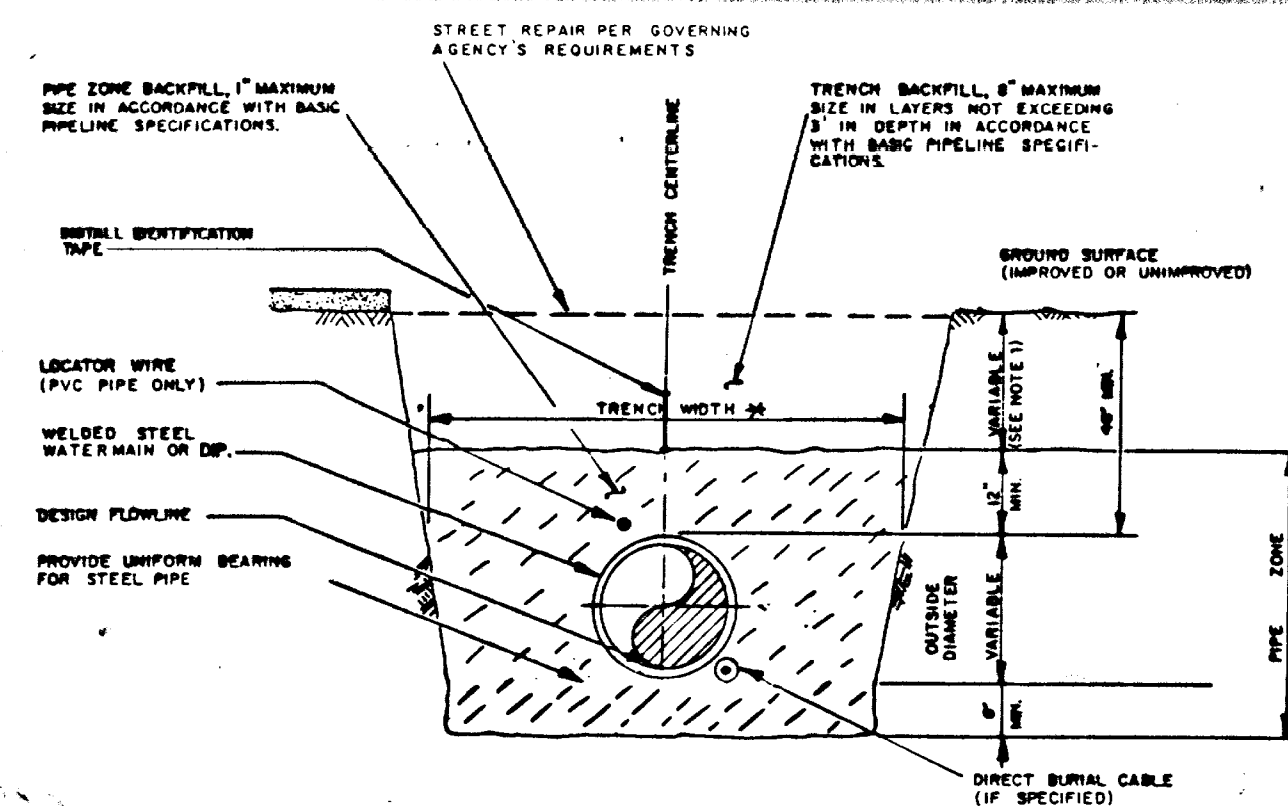


PIPE DIAMETER (INCHES)	TRENCH WIDTH (FEET)	
	MINIMUM (FEET)	MAXIMUM (FEET)
12 OR LESS	2.0	2.5
14 THRU 18	2.5	3.5
20 THRU 27	3.0	4.0
30 THRU 36	4.0	5.0
39 THRU 42	4.5	5.5

AT TOP OF PIPE

- NOTES:
- TRENCH SIDES SHALL BE SLOPED OR SHORED IN ACCORDANCE WITH CAL-OSHA CONSTRUCTION SAFETY ORDERS FOR TRENCH DEPTHS 5' AND GREATER.
 - ALL EXISTING PAVEMENT SHALL BE SAW CUT PRIOR TO TRENCHING, AND WHERE TRENCH SIDES SLOPE AND PAVEMENT BREAKS AWAY, IT SHALL BE SAW CUT PRIOR TO PERMANENT PAVEMENT REPAIR.
 - WHERE BOTTOM OF EXCAVATION IS IN ROCK WHICH CANNOT BE EXCAVATED TO PROVIDE UNIFORM BEARING FOR THE PIPE, TRENCH SHALL BE OVEREXCAVATED 8" MINIMUM AND REFILLED WITH SELECT EXCAVATED MATERIAL OR IMPORTED BACKFILL MATERIAL COMPACTED TO 90% MINIMUM RELATIVE COMPACTION.
 - WHENEVER BOTTOM OF TRENCH IS INSUFFICIENTLY STABLE TO PROVIDE A SUITABLE FOUNDATION FOR THE PIPE, TRENCH SHALL BE OVEREXCAVATED AS SPECIFIED AND REFILLED WITH SELECT EXCAVATED MATERIAL OR IMPORTED BACKFILL MATERIAL COMPACTED TO 90% MINIMUM RELATIVE COMPACTION.
 - WHENEVER EXISTING UTILITY FACILITIES, EXCEPT SEWERS, ARE ENCOUNTERED, PIPELINES SHALL CLEAR THEM BY 6" MINIMUM, BOTH HORIZONTALLY AND VERTICALLY, CONSISTENT WITH ABOVE PIPELINE REQUIREMENTS. PIPELINES SHALL CLEAR SEWERS IN ACCORDANCE WITH CALIFORNIA WATER WORKS STANDARDS. SPECIFIED CLEARANCES OR SEPARATIONS SHALL NOT BE REDUCED UNLESS ORDERED OR PERMITTED BY OWNER. PIPELINES SHALL NOT BE IN CONTACT WITH OR REST AGAINST OTHER UTILITY FACILITIES.
 - THIS DETAIL BASICALLY CONFORMS TO STANDARD DRAWING W-1550

TYPICAL TRENCH DETAIL


NOT TO SCALE

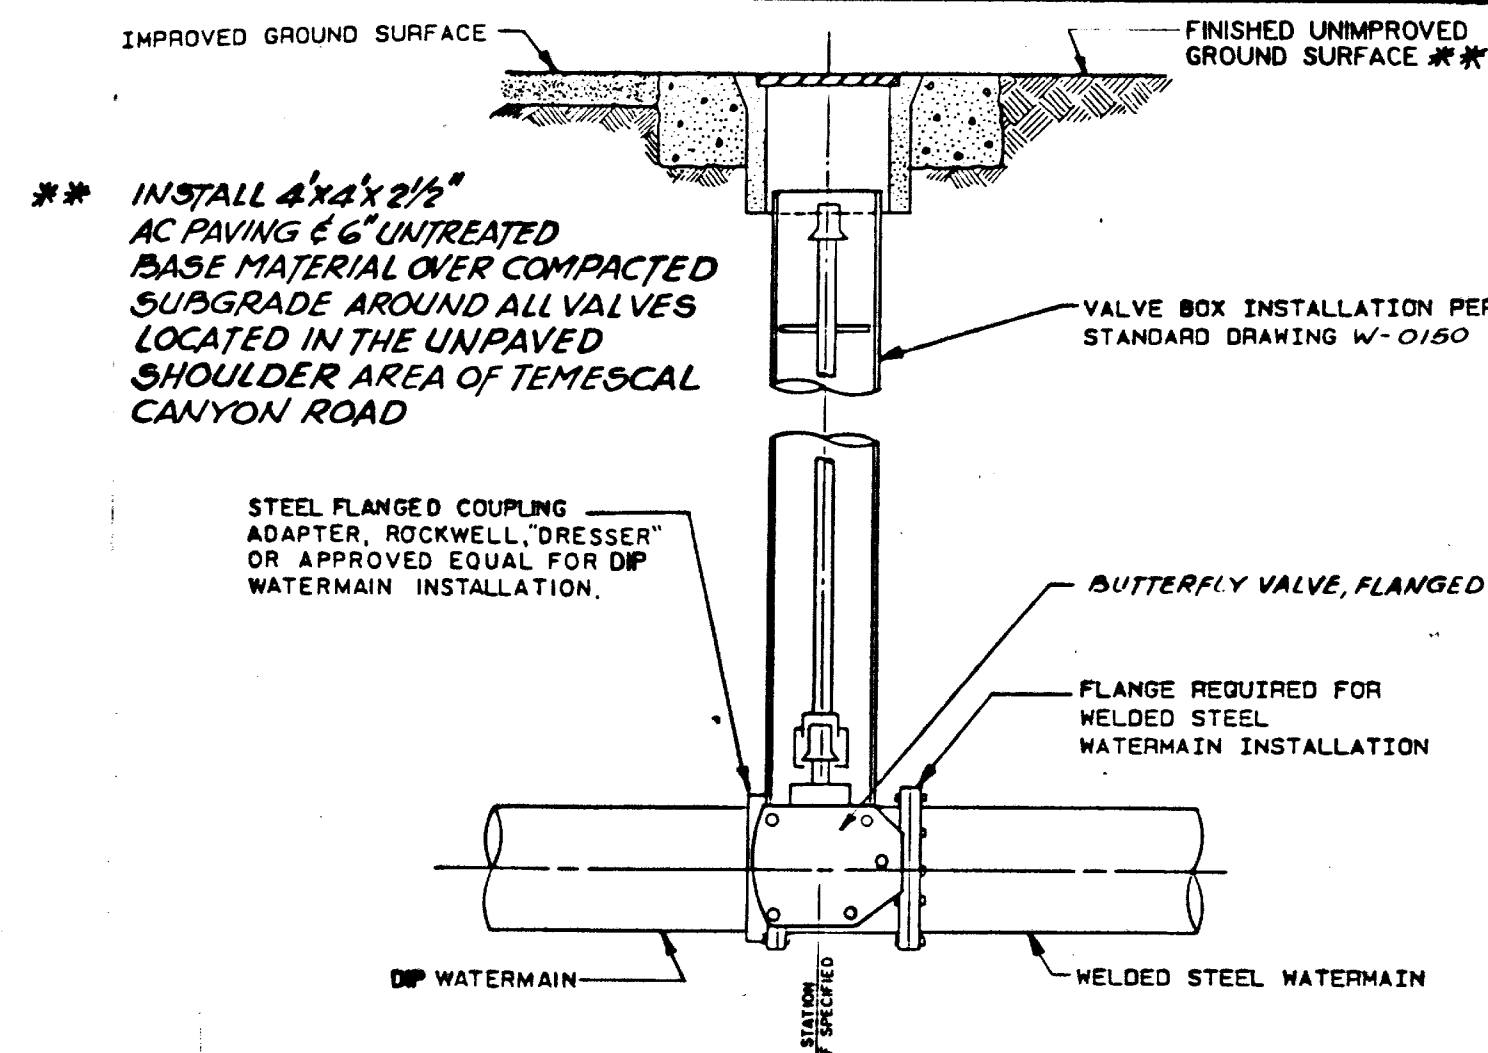

- NOTES:
- VALVE SHALL OPEN WITH COUNTERCLOCKWISE ROTATION OF OPERATING NUT.
 - BOLTS SHALL BE STANDARD SQUARE HEAD MACHINE PER ASTM A-307 WITH GRADE "B" HEX NUTS, COLD-PRESS SEMI-FINISHED STEEL PER ASTM A-194, GRADE "2H". THREADS SHALL BE LUBRICATED WITH GRAPHITE AND OIL. AFTER INSTALLATION, ALL EXPOSED STEEL SHALL BE FIELD COATED WITH AN APPROVED BITUMASTIC.
 - VALVE SHALL BE LOCATED SO THAT OPERATOR AND OPERATING NUT ARE SITUATED ON STREET OR EASEMENT CENTERLINE SIDE OF VALVE.

VALVE INSTALLATION DETAIL

NOT TO SCALE

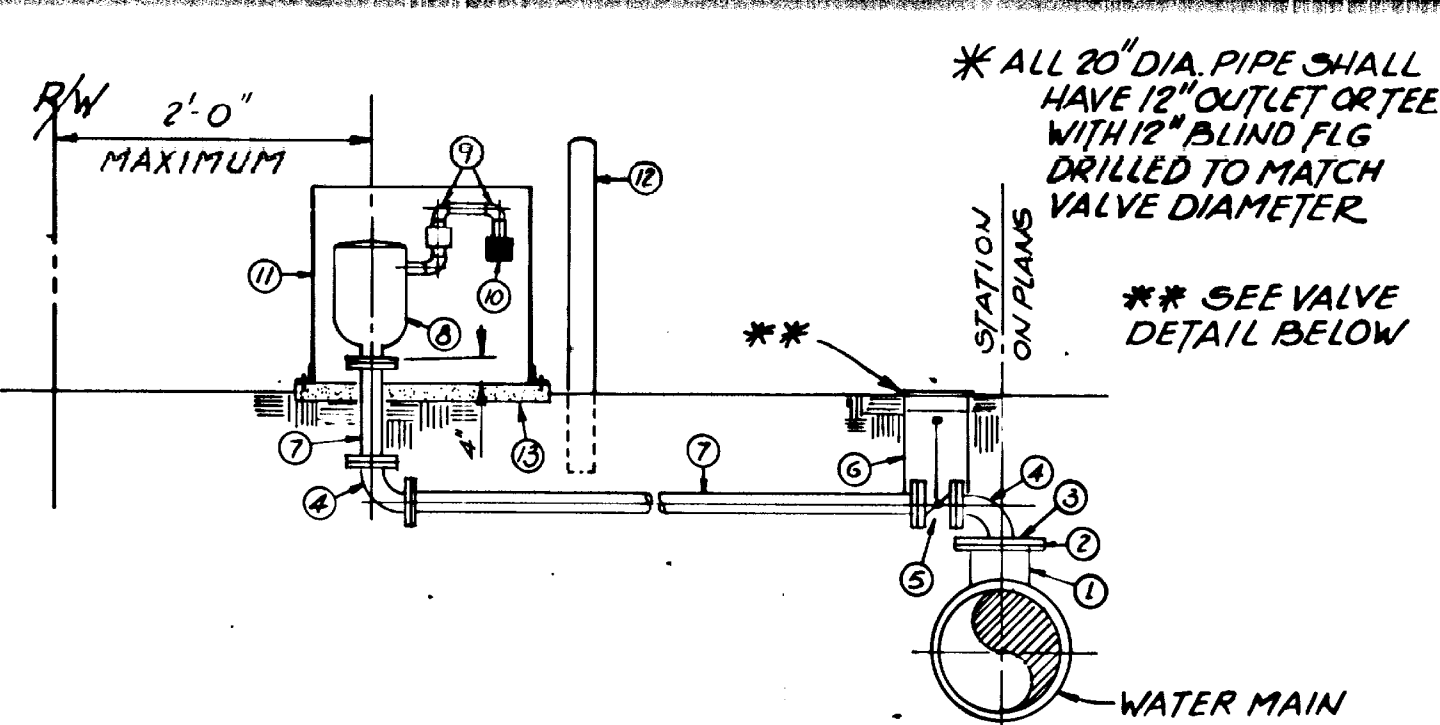


ITEM	NUMBER REQUIRED	DESCRIPTION
1*	1	12" STEEL OUTLET OR TEE
2	1	DIELECTRIC INSULATING FLG AND TEST STATION PER DETAIL, DRAWING NO. 20
3*	1	12" BLIND FLG DRILLED TO MATCH VALVE DIAMETER
4	2	STANDARD WEIGHT BLACK 90° STREET ELL FLGD
5	1	BUTTERFLY VALVE FLANGED
6	1	VALVE BOX INSTALLATION PER STD DWG W-0212
7	VARIES	STANDARD WEIGHT BLACK NIPPLE
8	1	COMBINATION AIR VACUUM-AIR RELEASE VALVE APCO SERIES 1100A OR APPROVED EQUAL
9	3	STD. WEIGHT BLACK STL 90° STREET ELBOW
10	1	AIR VALVE SCREEN, 6" DIA MIN
11	1	10 GA WELDED STL PLATE AIR VAC ENCLOSURE
12	2	GUARD POSTS PER STD. DWG W-1520
13	1	4'x4'x6" CONC. SLAB W/6'x6'x1/4" WIRE MESH

- NOTES:
- PIPE THREADS SHALL BE CLEAN AND SHARP AND SEALED WITH APPROVED JOINT COMPOUND.
 - PIPE TO BE TAPE WRAPPED WITH "PROTECTO WRAP" #200A PLASTIC TAPE (40 MIL MINIMUM THICKNESS) WITH #1170 PRIMER LAPPED 60 PERCENT, OR APPROVED EQUAL.
 - EXPOSED PIPING, AIR VALVE, AIR VALVE COVER, AND AIR VALVE SCREEN, EXCEPT WIRE CLOTH AND STAINLESS STEEL BANDS, SHALL BE PAINTED IN ACCORDANCE WITH THE BASIC PAINTING SPECIFICATIONS. THE FINAL TWO COATS SHALL BE SUNSET YELLOW (RUST-OLEUM).
 - PIPING SHALL CLEAR EXISTING PIPING BY 12" MINIMUM OR AS APPROVED BY THE OWNER.
 - PIPING, FITTINGS AND VALVES SHALL BE THE SAME DIAMETER AS THE AIR RELEASE VALVE SHOWN ON THE PLANS.

AIR RELEASE VALVE DETAIL


NOT TO SCALE

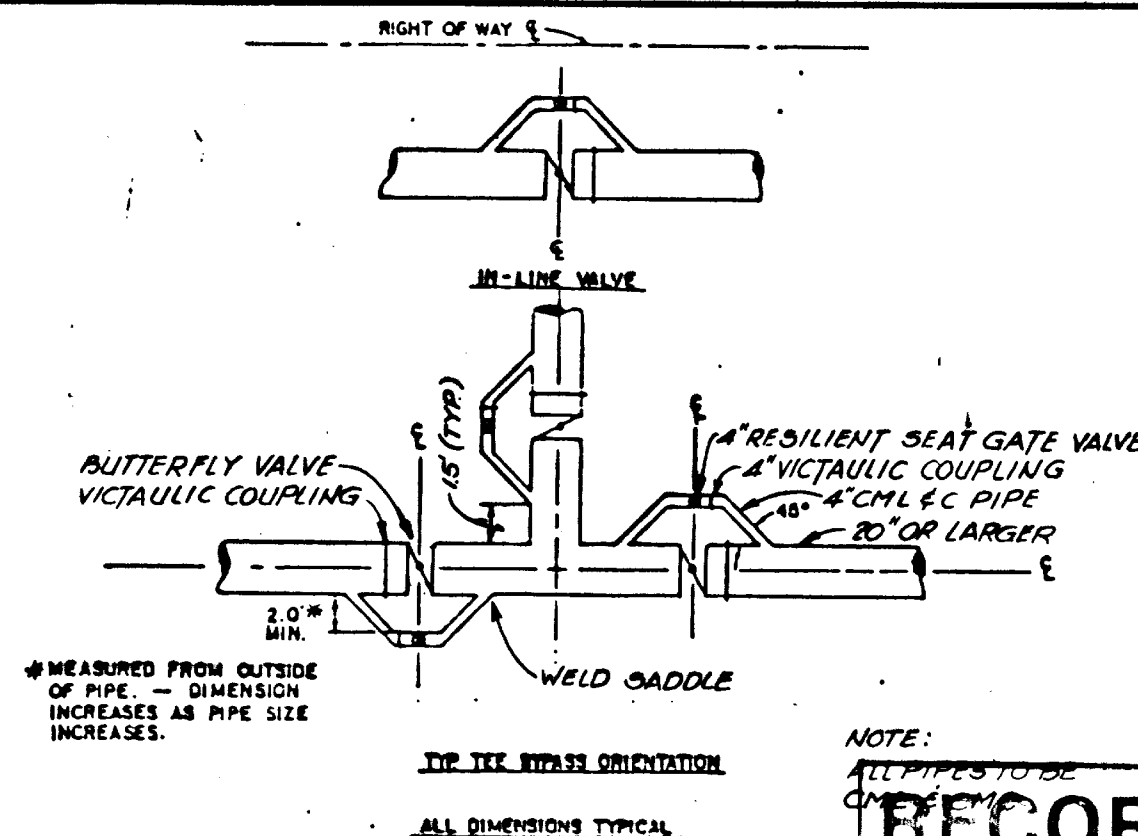

- NOTES:
- BYPASS ASSEMBLY TO BE INSTALLED ON ALL VALVES 20" OR LARGER.
 - BYPASS ASSEMBLY TO BE LOCATED ON RIGHT SIDE OF MAIN WHEN FACING THE CROSS OR TEE.
 - EXCLUDING TEES AND CROSSES, BYPASS ASSEMBLY TO BE LOCATED TOWARDS RIGHT OF WAY CENTER LINE ON ALL INLINE VALVES.
 - MAINLINE VALVE OPERATING NUT TO BE LOCATED ON SAME SIDE OF MAIN AS BYPASS ASSEMBLY.
 - BYPASS VALVE TO BE CENTERED ON MAINLINE VALVE.
 - BYPASS DETAIL TO BE SUBMITTED TO OWNER FOR APPROVAL PRIOR TO FABRICATION.

BYPASS VALVE DETAIL

NOT TO SCALE

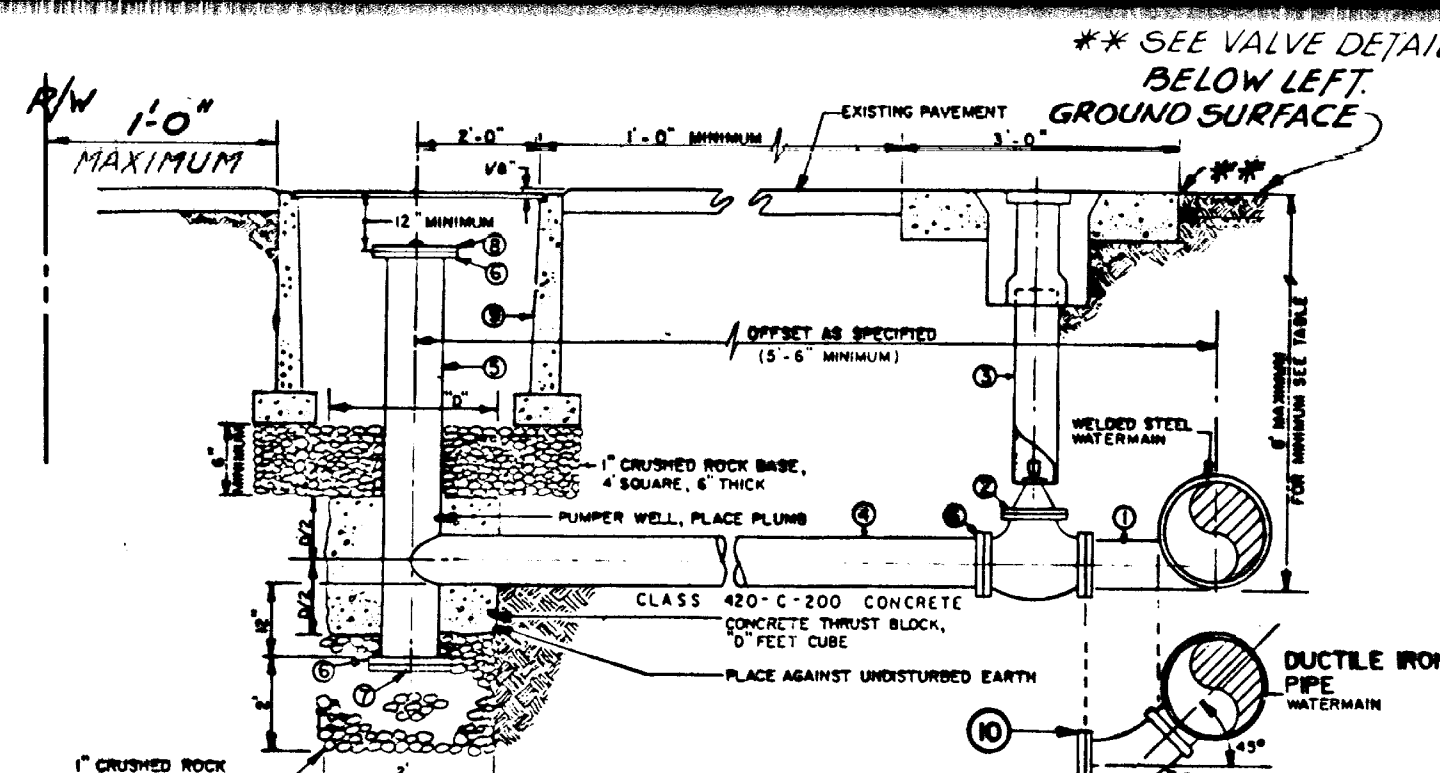


ITEM	NUMBER REQUIRED	DESCRIPTION
1	1	FLANGED TANGENTIAL SIDE OUTLET ON WELDED STEEL WATERMAIN OR FLANGED CAST IRON TEE WITH FLANGED CAST IRON 45° ELL ON DIP WATERMAIN
2	1	FLANGED GATE VALVE
3	1	VALVE BOX INSTALLATION PER STANDARD DRAWING W-0212
4	VARIES	10 GAGE CEMENT MORTAR LINED AND CEMENT MORTAR COATED WELDED STEEL PIPE AND FITTINGS.
5	VARIES	10 GAGE CEMENT MORTAR LINED AND CEMENT MORTAR COATED WELDED STEEL PUMPER WELL.
6	2	ANNA CLASS D FLANGE.
7	1	ANNA CLASS D BLIND FLANGE WITH 3/8" DIAMETER WEEP HOLE.
8	1	ANNA CLASS D BLIND FLANGE WITH 1" SCREW TAP AND ELL.
9	2	BLOWOFF VAULT PER STANDARD DRAWING W-0212
10	1	DIELECTRIC INSULATING FLG & TEST STATION SEE DETAIL, DWG. NO. 20

- NOTES:
- VARIABLE DIMENSIONS SHALL BE FIELD MEASURED BY CONTRACTOR AND APPROVED BY AGENCY PRIOR TO FABRICATION UNLESS SUFFICIENT DIMENSIONS ARE CONTAINED ON CONSTRUCTION DRAWINGS. FIELD JOINTS MAY BE FLANGED OR WELDED BUT SHALL NOT PERMANENTLY IMPAIR INTERIOR LINING OF PIPE.
 - IF WELDED STEEL WATERMAIN IS OTHER THAN CEMENT MORTAR LINED AND CEMENT MORTAR COATED, LINING AND COATING FOR BLOWOFF PIPE AND FITTINGS SHALL MATCH WELDED STEEL WATERMAIN UNLESS SPECIFIED OTHERWISE.
 - BOLTS SHALL BE STANDARD HEX HEAD MACHINE PER ASTM A-307 WITH GRADE "B" HEX NUTS, COLD-PRESS SEMI-FINISHED STEEL PER ASTM A-194, GRADE "2H". BURIED THREADS SHALL BE LUBRICATED WITH GRAPHITE AND OIL, THEN COATED WITH BITUMASTIC.
 - ALL EXPOSED PIPING AND INTERIOR OF VAULT COVER SHALL BE FIELD PAINTED IN ACCORDANCE WITH THE BASIC PAINTING SPECIFICATIONS. THE FINAL TWO COATS SHALL BE FEDERAL SAFETY BLUE (RUST-OLEUM).
 - PIPING SHALL CLEAR EXISTING PIPING BY 12" MINIMUM OR AS APPROVED BY THE OWNER.

6" BLOWOFF DETAIL

NOT TO SCALE

PIPELINE	CASING DIAMETER	WALL THICKNESS
12" WATER	28"	1/2"
20" WATER	36"	1/2"
12" SEWER	28"	1/2"
15" SEWER	30"	1/2"

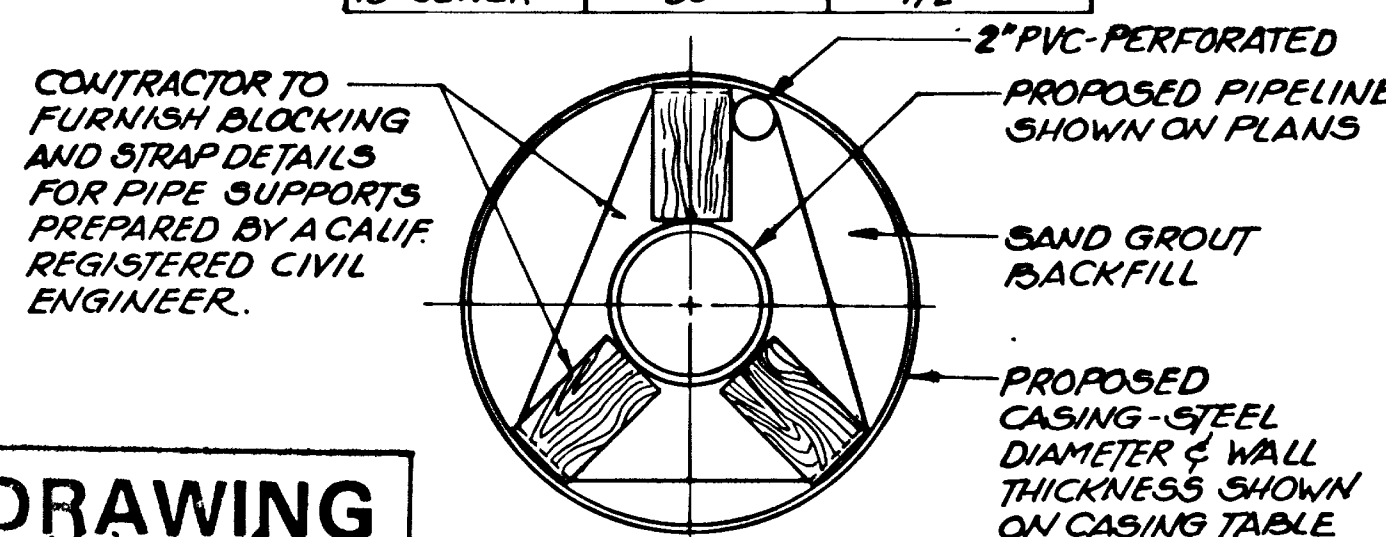

CASING DETAIL

NOT TO SCALE

RECORD DRAWING
Date: 12/1/92
By: [Signature]
CAMP DRESSER & MCKEE INC.




RECOMMENDED BY:
[Signature]
JSME R.C.E.
DATE: 2/27/91

APPROVED BY:
[Signature]
DISTRICT MANAGER
DATE: 2/1/91

CONCRETE ENCASEMENT DETAIL

NOT TO SCALE

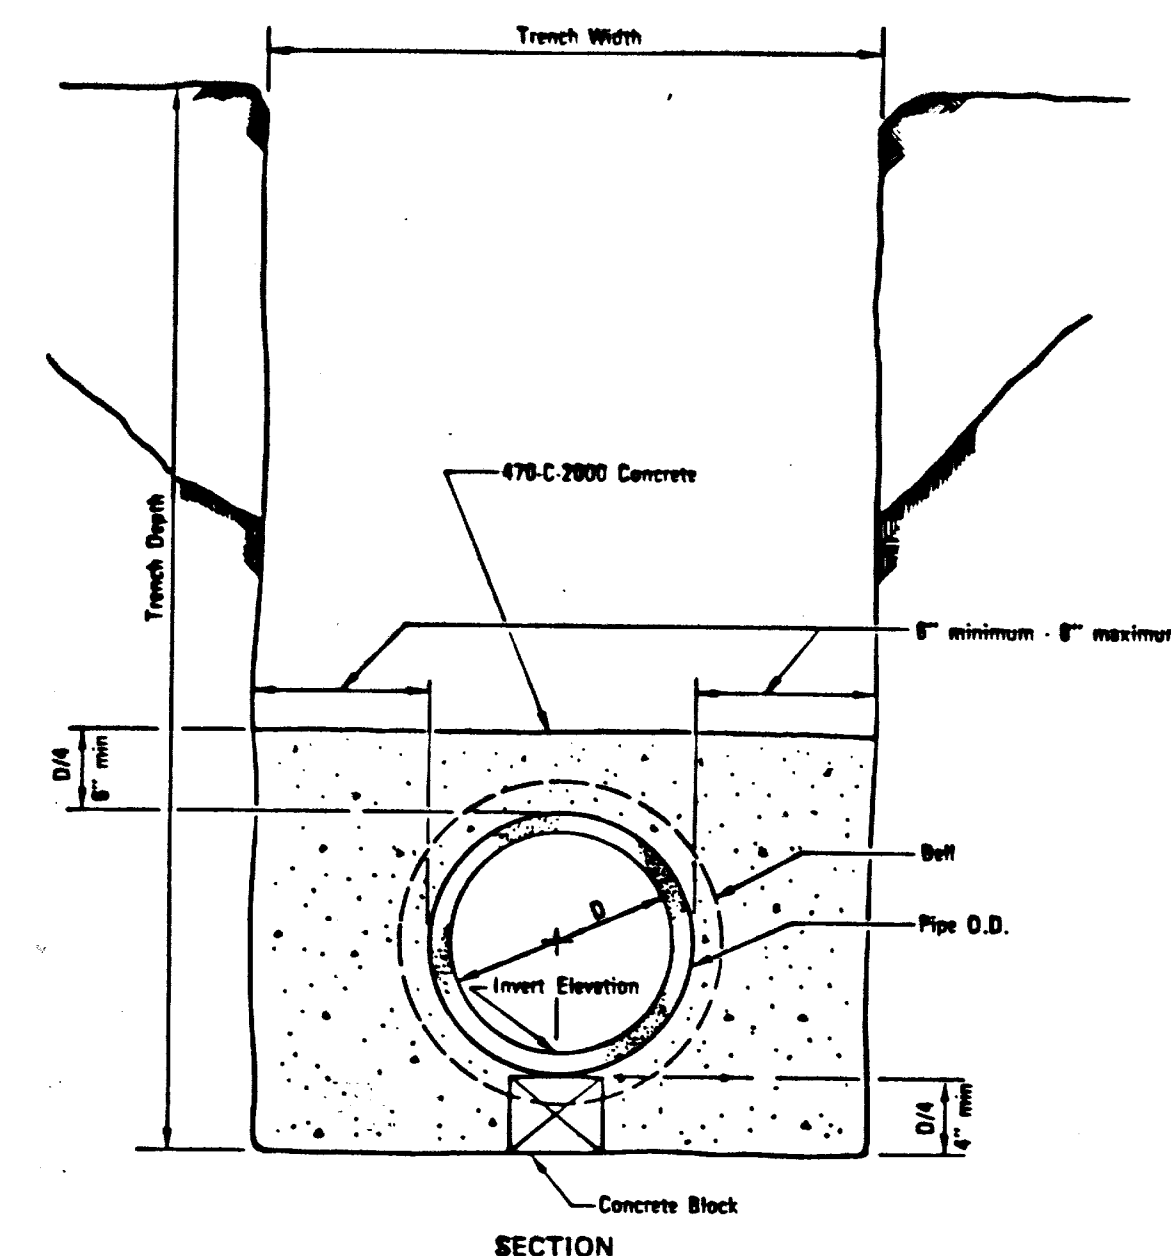

NOTE:
Encase pipe to the nearest flexible joint.

STANDARD DRAWING REFERENCES ARE TO WESTERN MUNICIPAL WATER DISTRICT "WATER AND SEWERAGE SYSTEM-DESIGN AND CONSTRUCTION MANUAL", FEBRUARY, 1990 EDITION, ADOPTED BY THE LEE LAKE BOARD OF DIRECTORS.

Lee Lake Water District
PHASE 1B CONSTRUCTION


DESIGNED	CHECKED	DRAWN	DATE	REVISIONS	INITIALS	DATE
RLV	KAY/MAT	PC/LLD				

DESIGNED	CHECKED	DRAWN	DATE	REVISIONS	INITIALS	DATE
RLV	KAY/MAT	PC/LLD				


JSME
John S. Mark engineers, Inc.
7770 El Camino Real
Carlsbad, California 92009
(619) 942-2100

LEE LAKE WATER DISTRICT
MISCELLANEOUS DETAILS
TEMESCAL CANYON ROAD WATER LINE


SCALE
AS NOTED
SHEET NO. 18
OF 24 SHEETS
DWG. NO.
18

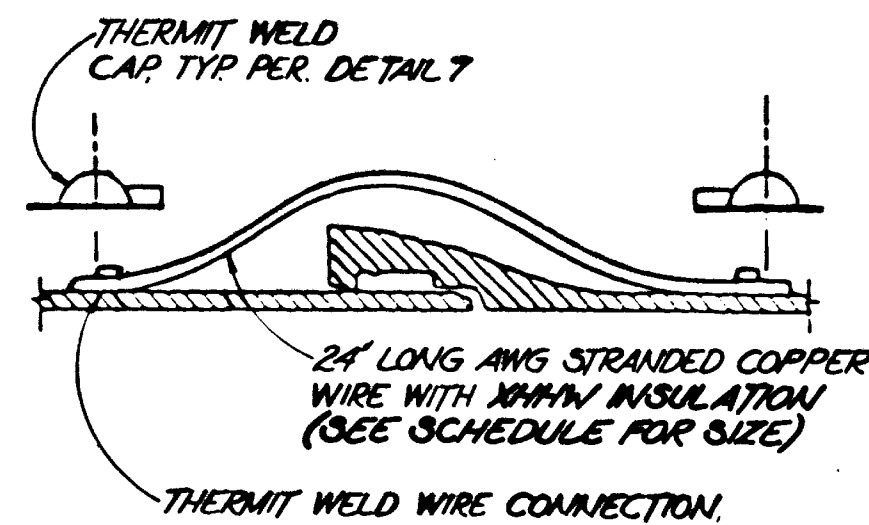

DUCTILE IRON
PUSH-ON JOINT BOND DETAIL ①
N.T.S.

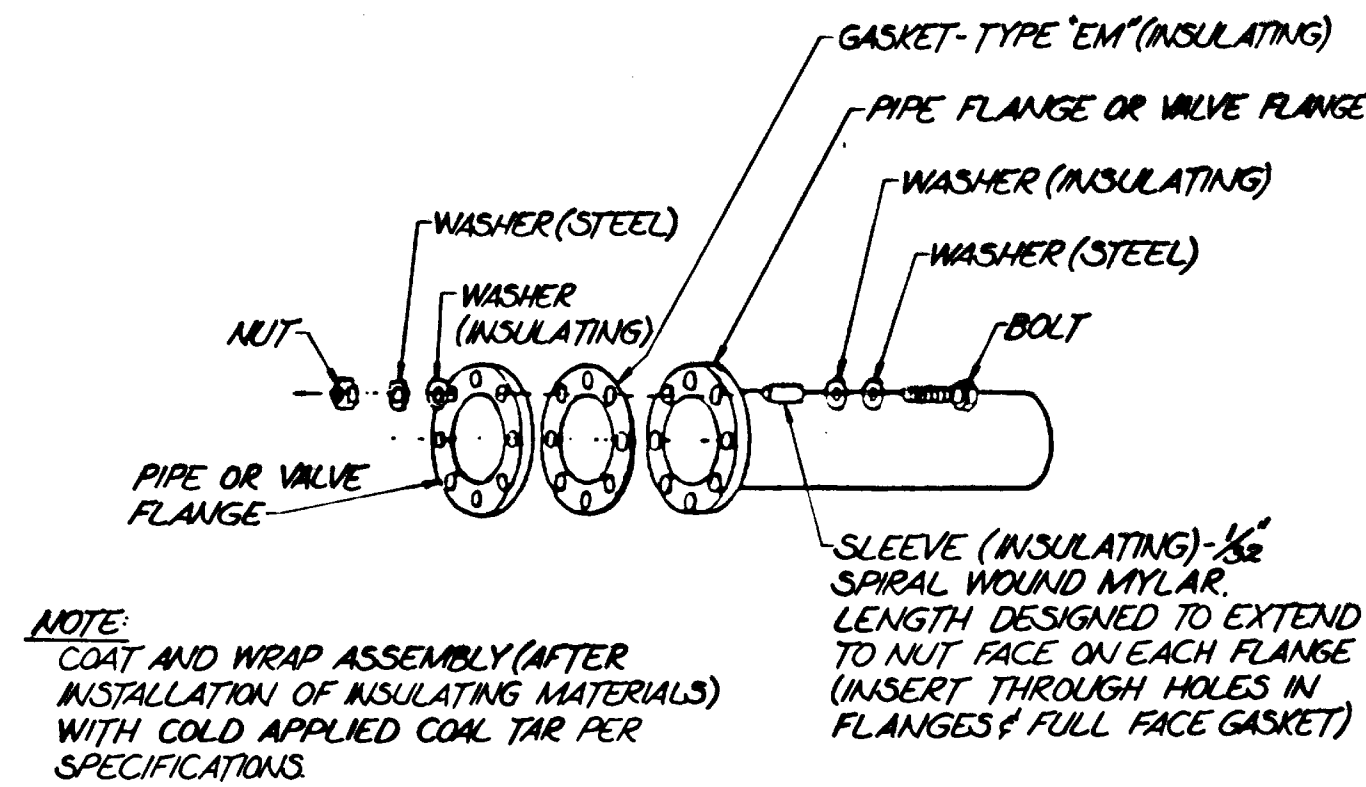


INSULATING FLANGE DETAIL ②
N.T.S.

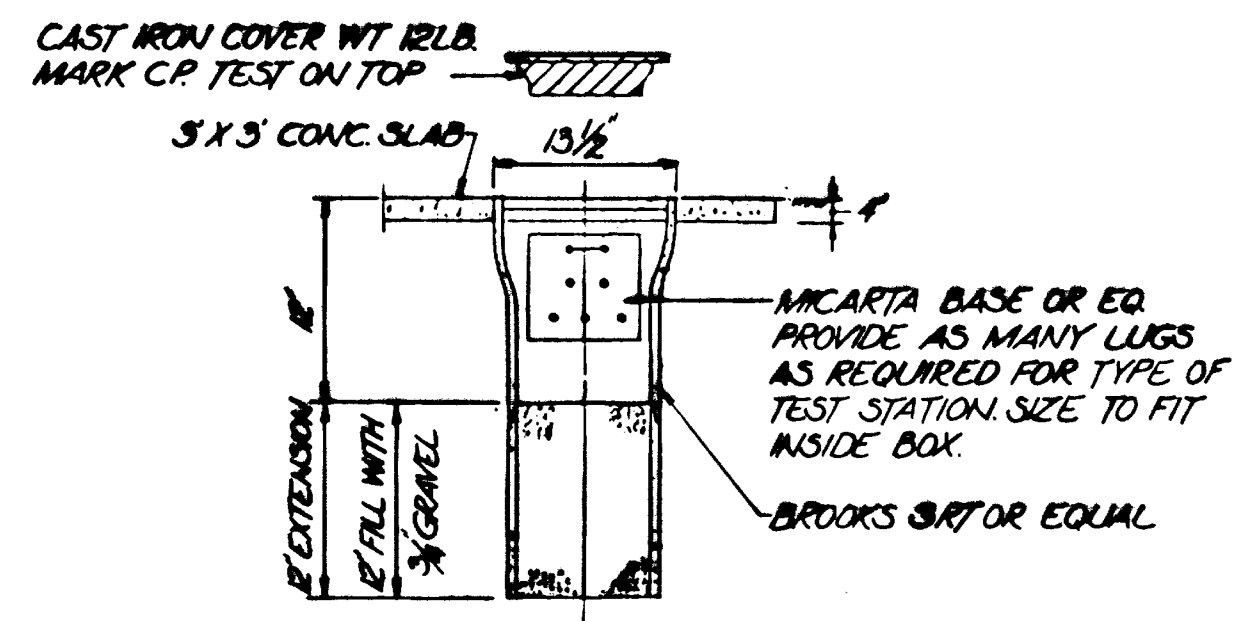


TEST LEAD BOX DETAIL ③
N.T.S.


BOND CABLE SIZE SCHEDULE				
PIPE MATERIAL	PIPE I.D. (in)	JOINT LENGTH (ft)	MIN SIZE WIRE (AWG)	TOTAL BOND LENGTH (in)
Steel Class 150	20	20	6	24
	20	40	8	24
Steel Class 200	20	20	4	24
	20	40	8	24
Steel Class 250	20	20	4	24
	20	40	6	24

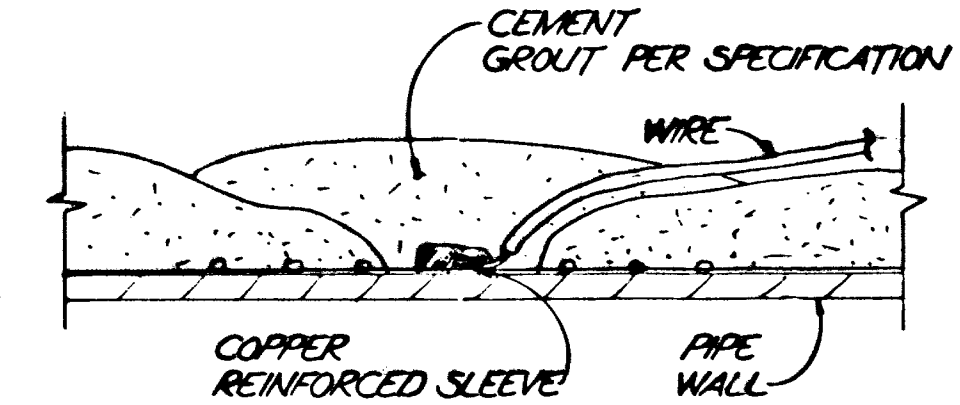


CML & C THERMIT WELD DETAIL ④
N.T.S.

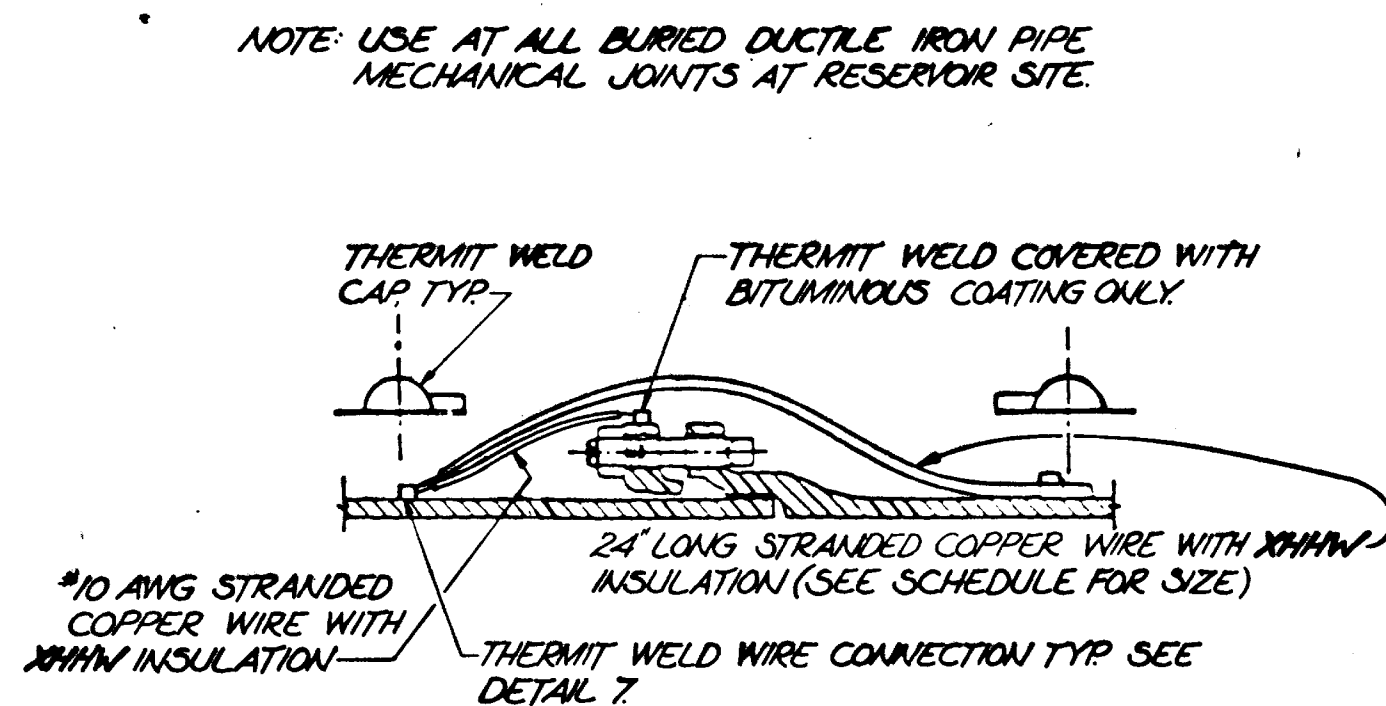

MECHANICAL JOINT BOND DETAIL ⑤
N.T.S.

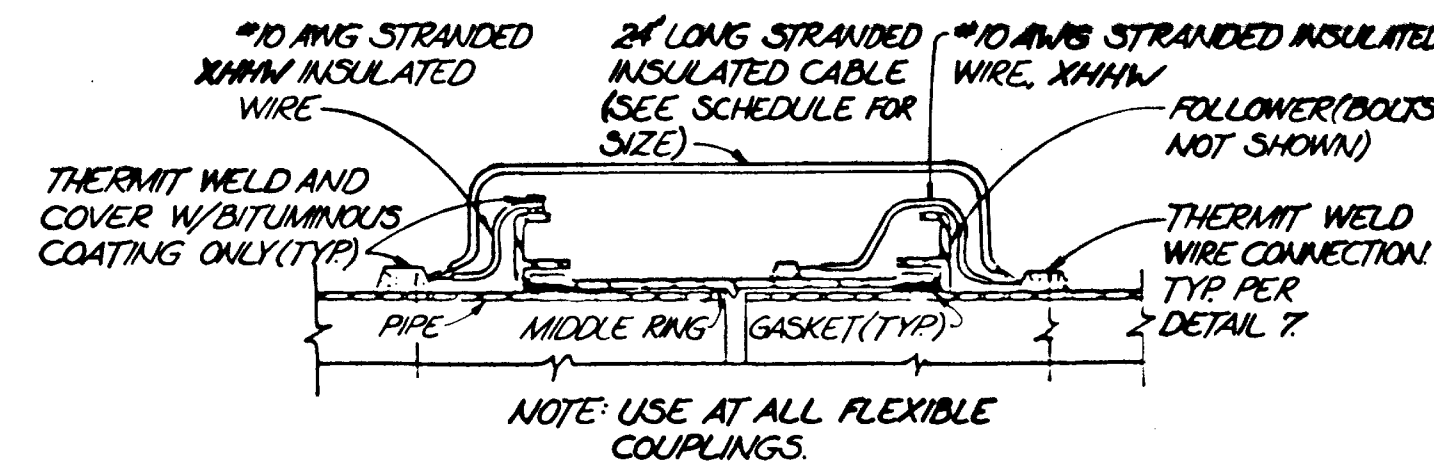

FLEXIBLE COUPLING BOND DETAIL ⑥
N.T.S.

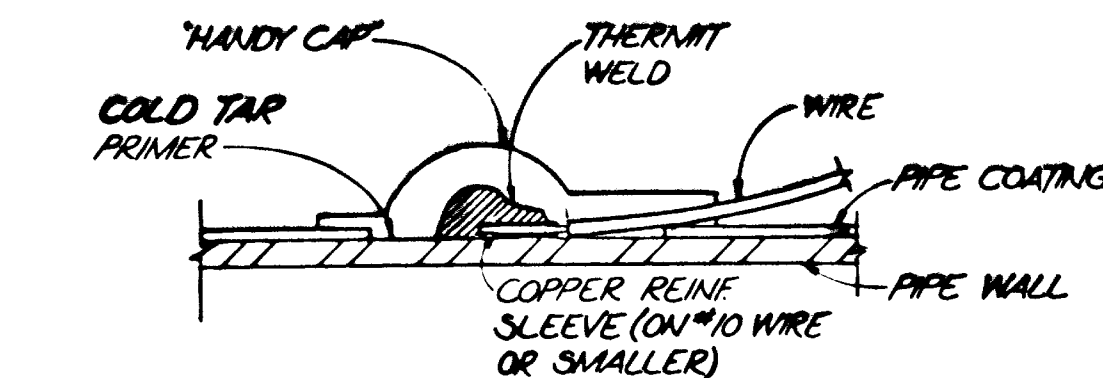


NOTES:


1. COAT WELD CONNECTION WITH BITUMINOUS COATING PRIOR TO PLACING CAP OVER WELD.

2. FOLLOW THERMIT WELD MANUFACTURER'S RECOMMENDATIONS FOR WELDING PROCEDURES.

DUCTILE IRON
THERMIT WELD DETAIL ⑦
N.T.S.

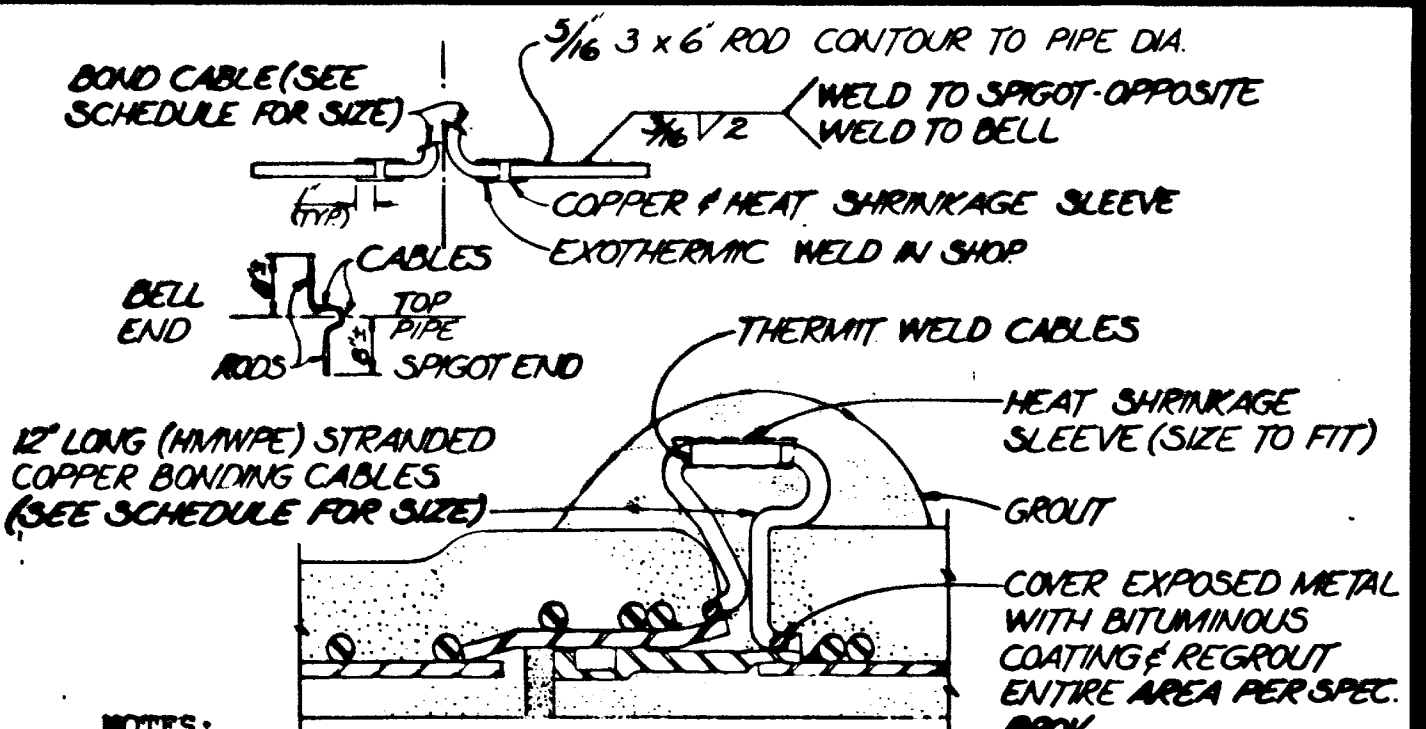


CONCRETE CYLINDER PIPE AND STEEL (CL & C) NON-WELDED JOINT BOND DETAIL ⑧
N.T.S.

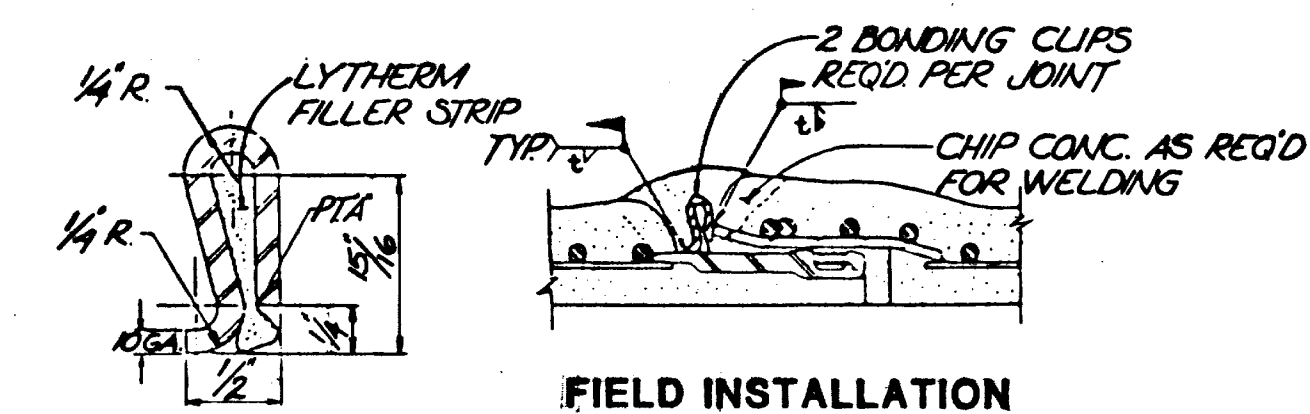


- STEEL BONDING CLIP:
MATERIAL SPECIFICATION...ASTM A366 (COMMERCIAL QUALITY)
CUT LENGTH.....2 1/2 INCH ± 1/16 INCH
WIDTH.....1 1/4 INCH ± 1/16 INCH
- LYTHERM FILLER STRIP TO BE 1 INCH BY 1 1/2 INCH WIDE TO OVERLAP SIDES OF CLIP.
- CRIMP THE STEEL JOINT BONDING CLIP OVER THE LYTHERM FILLER STRIP AT PT. "A" TO COMPRESS THE FILLER MATERIAL. CLOSE THE GAP AT PT. "A" AS MUCH AS POSSIBLE WITHOUT CUTTING THE LYTHERM FILLER STRIP.
- IF THE LYTHERM FILLER STRIP IS CUT AT PT. "A" REMOVE THE ENTIRE STRIP AND REPLACE WITH A NEW LYTHERM FILLER STRIP PER THIS DETAIL.
- INSTALL THE STEEL BONDING CLIPS ALONG THE TOP PORTION OF THE PIPE.

CARNEGIE JOINT M.L.C.P.
OR S.C.C.P. DETAIL ⑨
N.T.S.

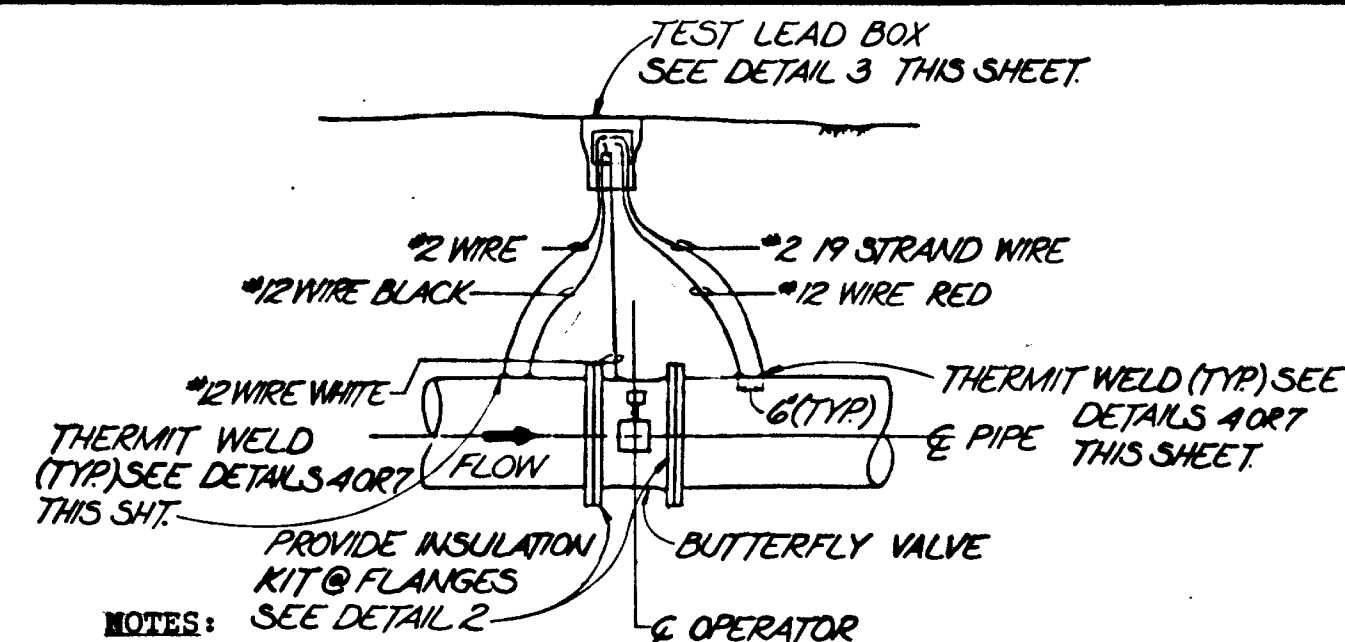


- LEAD WIRE COLOR AND PIPE STATION MUST BE RECORDED.
- TEST LEADS SHALL NOT HAVE SPLICES.
- PROVIDE THERMIT WELD CAPS AS SPECIFIED.
- TYPE XHHW INSULATION ON ALL LEAD WIRES.

VALVE & INSULATOR
TEST STATION DETAIL ⑩
N.T.S.

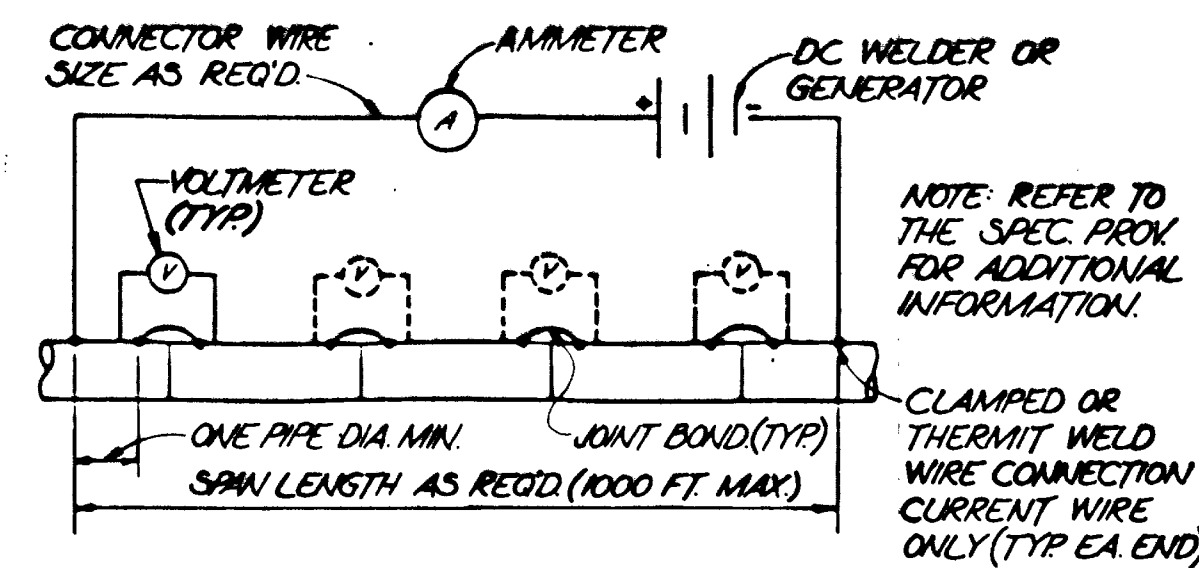

CONTINUITY TEST SCHEMATIC DETAIL ⑪
N.T.S.

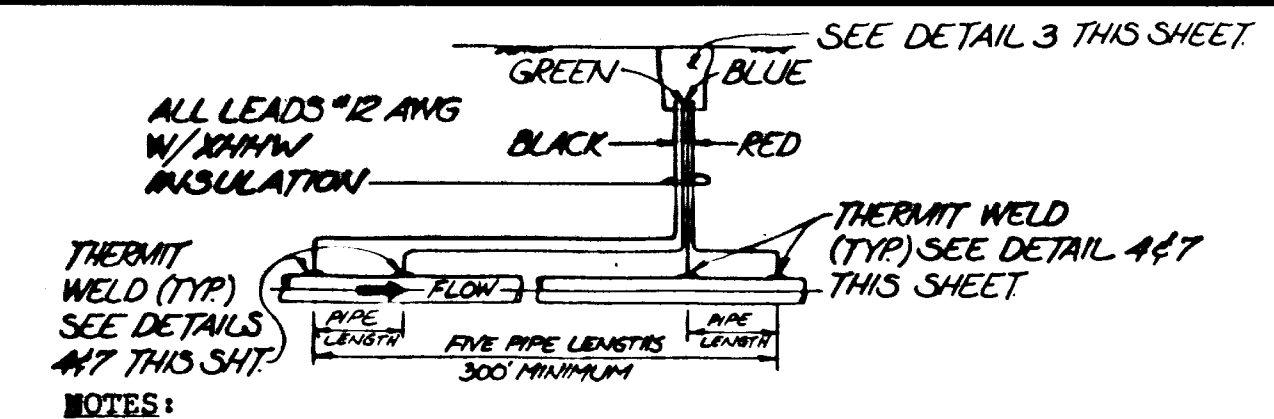


- LEAD WIRE COLOR AND PIPE STATION MUST BE RECORDED.
- TEST LEADS SHALL NOT HAVE SPLICES.
- PROVIDE THERMIT WELD CAPS AS SPECIFIED.

RECORD DRAWING

Date: 12/10/12 By: Keith C. Row

CAMP DRESSER & MCKEE INC.

CORROSION
TEST STATION DETAIL ⑫
N.T.S.

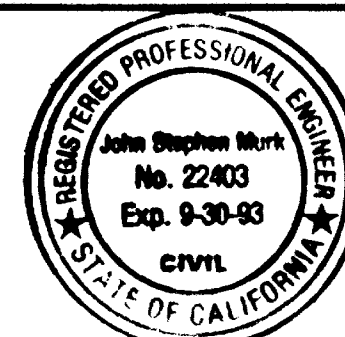

RECOMMENDED BY:
John S. Murphree
JSM R.C.E.
DATE: 8/27/11

APPROVED BY:
Keith C. Row
DISTRICT MANAGER
DATE: 10/1/11

Lee Lake Water District
PHASE 1B CONSTRUCTION

SCALE NONE
SHEET NO. 20
OF 24 SHEETS
DWG. NO. 80

JSM&E
John S. Murphree Engineers, Inc.
7770 El Camino Real
Carlsbad, California 92009
(619) 942-2100

LEE LAKE WATER DISTRICT
MISCELLANEOUS DETAILS III
TEMESCAL CANYON ROAD WATER LINE
CORROSION TESTING DETAILS

DESIGNED
STAFF
CHECKED
KJA/MT
DRAWN
JSD/CLP
DATE
NO.
REVISONS
INITIALS
DATE

