





THIS DOCUMENT AND THE IDEAS AND DESIGN INCORPORATED HEREIN ARE AN INSTRUMENT OF PROFESSIONAL SERVICE, IS THE PROPERTY OF SUMMIT ENGINEERING, INC. AND IS NOT TO BE USED IN WHOLE OR IN PART FOR ANY OTHER PROJECT WITHOUT THE WRITTEN AUTHORIZATION OF SUMMIT ENGINEERING, INC.

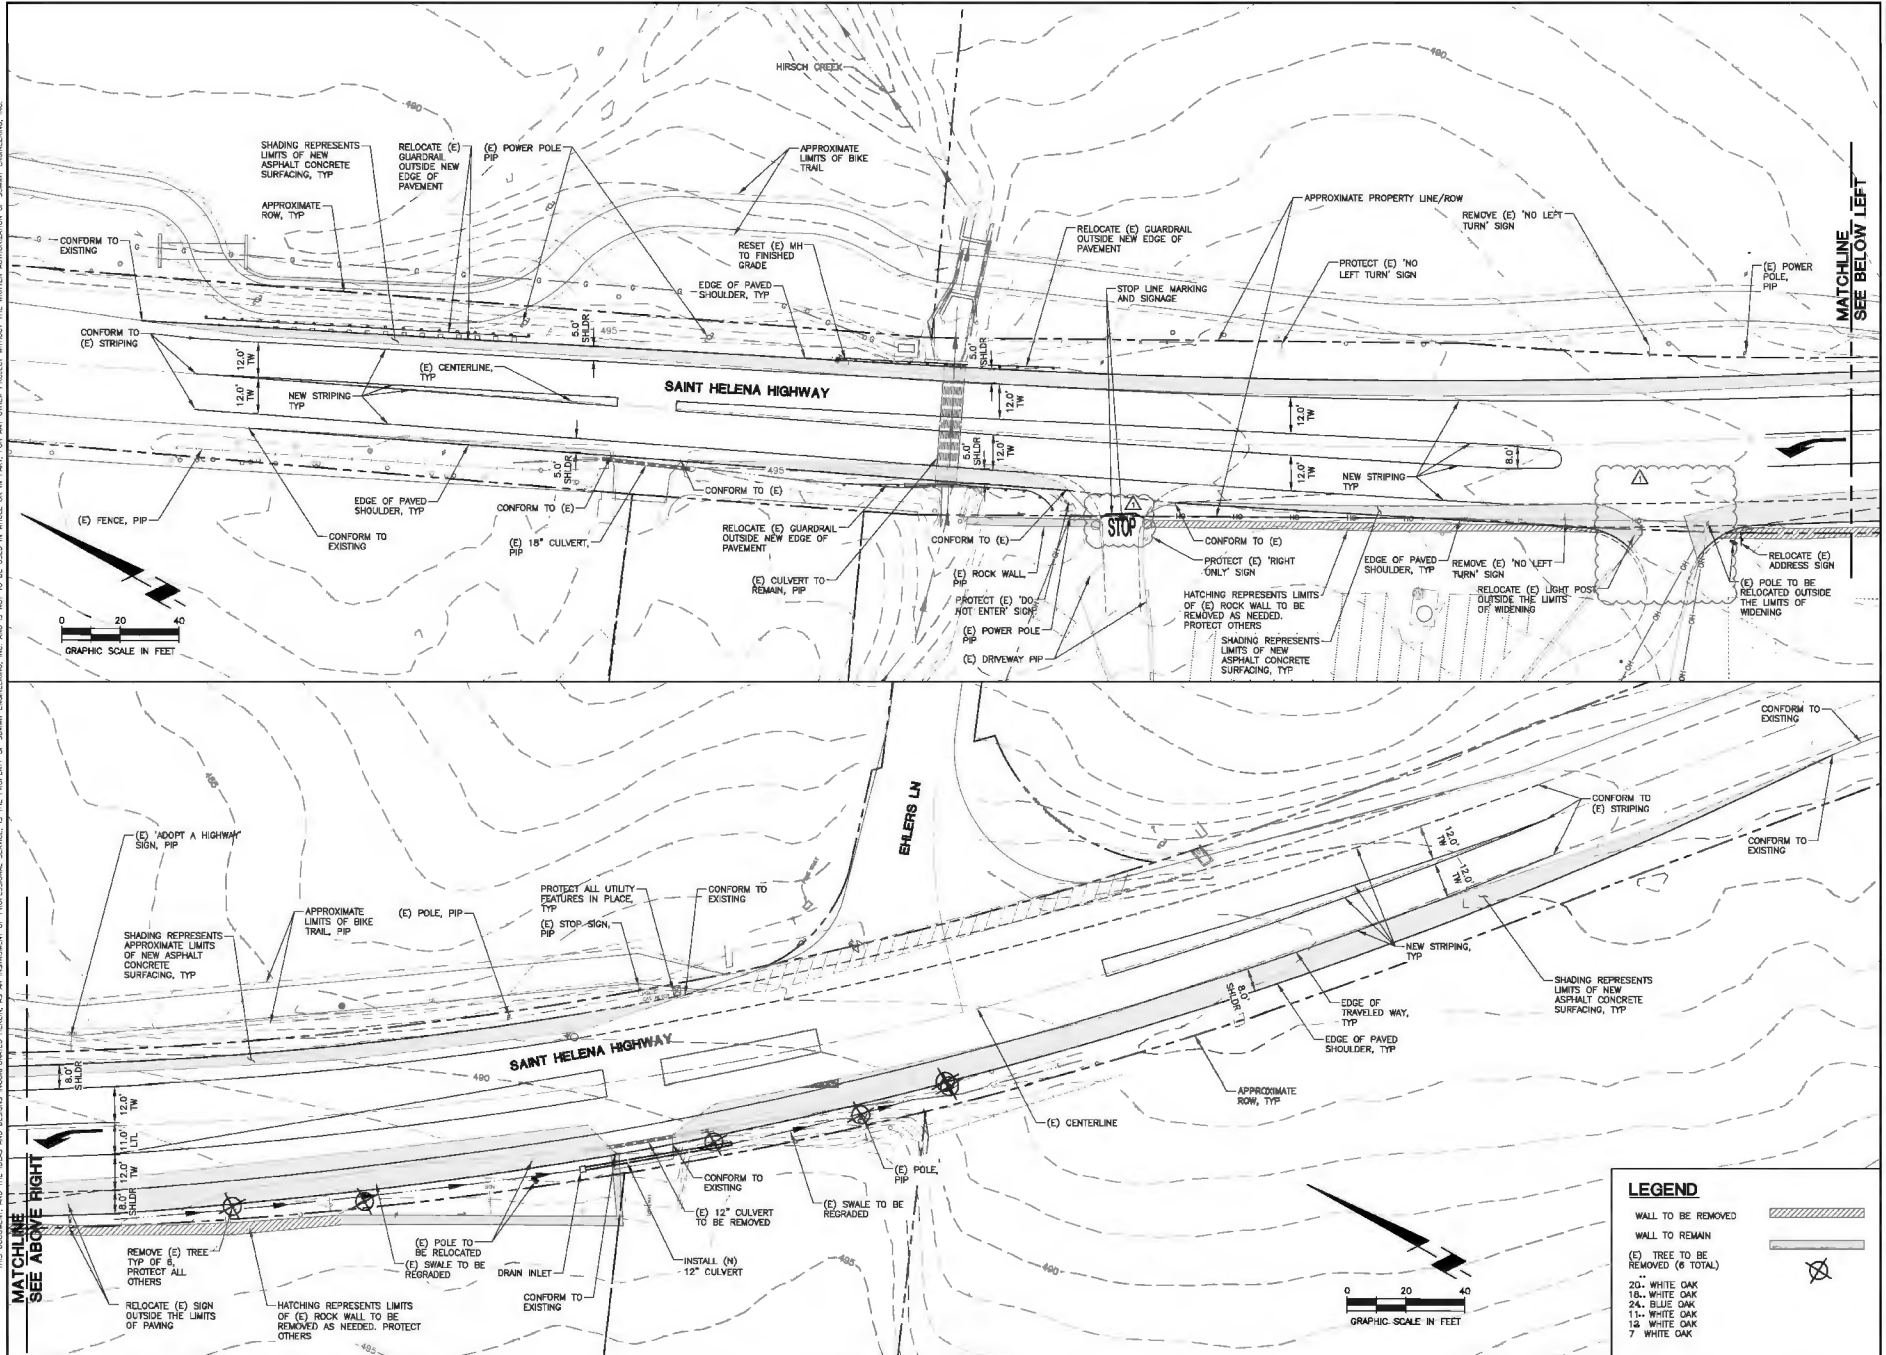

2/11/25	ISSUED FOR CLIENT REVIEW
4/01/25	ISSUED FOR CLIENT REVIEW
6/12/25	PLAN CHECK RESPONSE

DATE:	2025-02-13
JOB NO.:	2021183
SCALE:	AS SHOWN
DRAWN:	BV
CHECKED:	MS
SHEET	C2
	2 OF 3

THIS DOCUMENT AND THE IDEAS AND DECISIONS INCORPORATED HEREIN, AS AN INSTRUMENT OF PROFESSIONAL SERVICE, IS THE PROPERTY OF SUMMIT ENGINEERING, INC. AND IS NOT TO BE USED IN WHOLE OR IN PART FOR ANY OTHER PROJECT WITHOUT THE WRITTEN AUTHORIZATION OF SUMMIT ENGINEERING, INC.

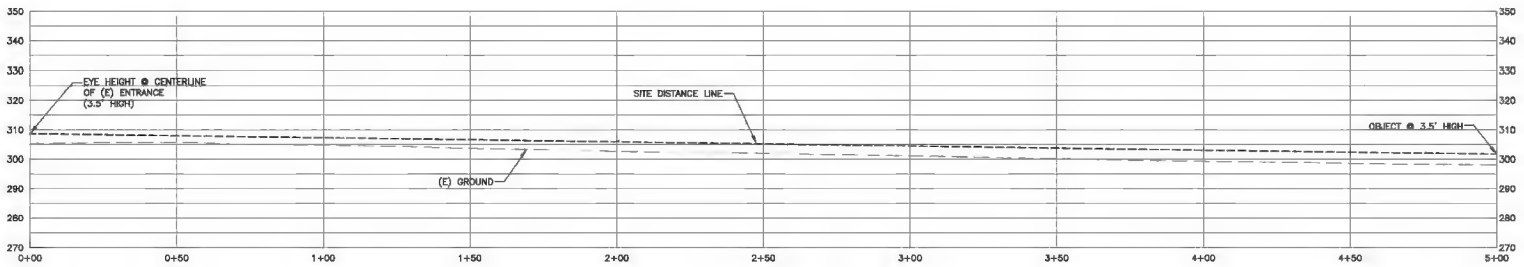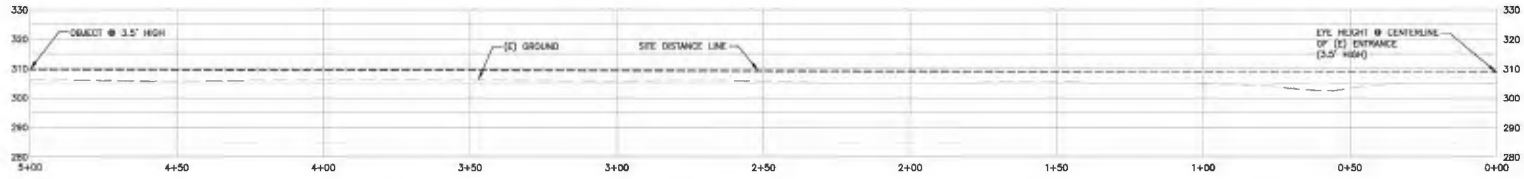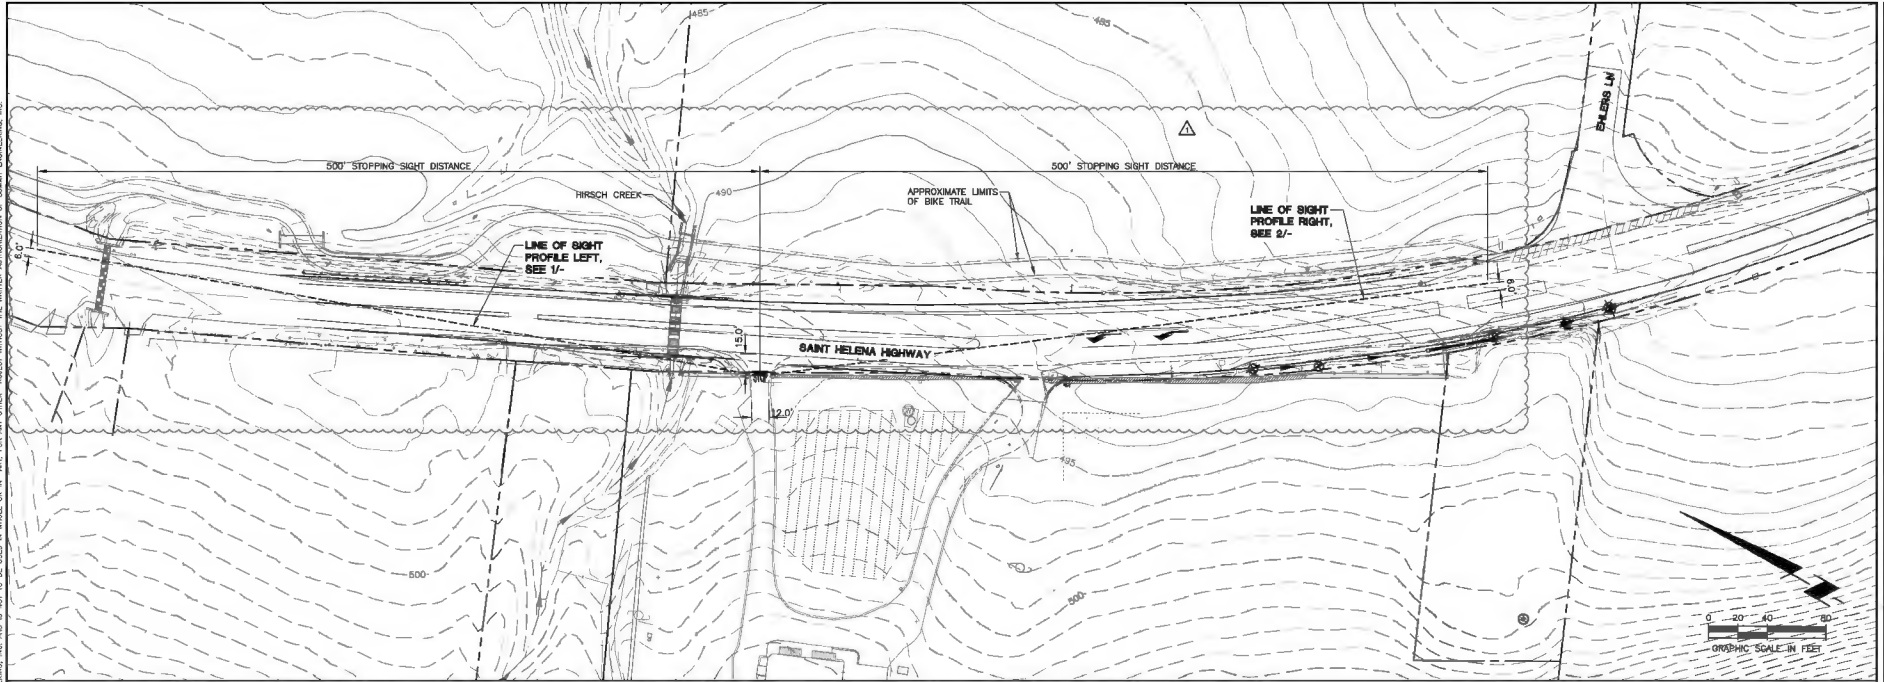

2/11/20	ISSUED FOR CLIENT REVIEW
4/03/20	ISSUED FOR CLIENT REVIEW
6/12/20	PLAN CHECK RESPONSE

DATE:	2025-02-13
JOB NO.:	2021183
SCALE:	AS SHOWN
DRAWN:	BY
CHECKED:	MS
SHEET:	C3