

OCT 04 2024

DONNA HILLEGASS, Clerk
BY BRIDGETTE EVANS
DEPUTY CLERK

NOTICE OF EXEMPTION

TO: X Office of Planning Research
P.O. Box 3044, Rm. 212
Sacramento, CA 95812

FROM: Lead Agency:
County Of Yuba, CDSA
915 8th Street, Suite 123
Marysville, CA 95901

or

X County Clerk, County of Yuba
915 8th Street
Marysville, CA 95901

SUBJECT: Filing of Notice of Exemption

PROJECT TITLE/CASE NO.: CEQA-24-0013 (Loma Rica Road Culvert Replacement Project)

PROJECT LOCATION - SPECIFIC AND COMMUNITY:

The project will be located on Loma Rica Road, between HWY 20 and Fruitland Road, in the unincorporated community of Loma Rica in Yuba County.

DESCRIPTION OF NATURE, PURPOSE, AND BENEFICIARIES OF PROJECT:

The Yuba County Public Works Department is undertaking a project to repair and replace nine culverts along existing roadways within Yuba County. Replacing the culverts is necessary to ensure the continued safety and functionality of the road system. Four locations (Locations 5, 6, 7, and 10) were removed from the project scope due to complications with blue line streams. This adjustment ensures the project will avoid potential impacts on jurisdictional waters.

NAME OF PUBLIC AGENCY\CONTACT PERSON\TELEPHONE #: County of Yuba CDSA,
Ciara Fisher, (530) 749-5470

NAME OF PERSON OR AGENCY CARRYING OUT PROJECT:

Yuba County Public Works Department
Attn: Brett Poliquin
915 8th Street, Suite 125
Marysville, CA 95901
(530) 749-5420

EXEMPT STATUS:

x Categorical Exemption: Sec. 15301 (d)

REASONS WHY PROJECT IS EXEMPT: This project is exempt under CEQA Guidelines Section 15301 (d) (Class 1), which applies to the restoration or rehabilitation of deteriorated or damaged structures and facilities to meet current standards of public health and safety. The work will be conducted entirely within the existing right-of-way, with minimal ground disturbance, and is intended to restore the road's safety and functionality without altering its capacity or footprint.

CONTACT PERSON: Ciara Fisher

TELEPHONE NO.: 530-749-5470

SIGNATURE

Ciara Fisher

TITLE

Planner III

DATE RECEIVED FOR FILING

10/04/2024

2024 FG-00048



State of California - Department of Fish and Wildlife

2024 ENVIRONMENTAL DOCUMENT FILING FEE

CASH RECEIPT

DFW 753.5a (REV. 01/01/24) Previously DFG 753.5a

RECEIPT NUMBER:

58 - 10042024 - 48

STATE CLEARINGHOUSE NUMBER (If applicable)

SEE INSTRUCTIONS ON REVERSE. TYPE OR PRINT CLEARLY.

LEAD AGENCY COUNTY OF YUBA CDSA	LEAD AGENCY EMAIL	DATE 10/04/2024
COUNTY/STATE AGENCY OF FILING YUBA	DOCUMENT NUMBER 2024FG-00048	

PROJECT TITLE
CEQA-24-0013 (LOMA RICA CULVERT REPLACEMENT PROJECT)

PROJECT APPLICANT NAME YUBA COUNTY PUBLIC WORKS	PROJECT APPLICANT EMAIL	PHONE NUMBER (530) 749-5463
PROJECT APPLICANT ADDRESS 915 8TH STREET, SUITE 123	CITY MARYSVILLE	STATE CA
		ZIP CODE 95901

PROJECT APPLICANT (Check appropriate box)

☒ Local Public Agency ☐ School District ☐ Other Special District ☐ State Agency ☐ Private Entity

CHECK APPLICABLE FEES:

☐ Environmental Impact Report (EIR)	\$4,051.25	\$ _____
☐ Mitigated/Negative Declaration (MND)(ND)	\$2,916.75	\$ _____
☐ Certified Regulatory Program (CRP) document - payment due directly to CDFW	\$1,377.25	\$ _____

☒ Exempt from fee

☒ Notice of Exemption (attach)

☐ CDFW No Effect Determination (attach)

☐ Fee previously paid (attach previously issued cash receipt copy)

☐ Water Right Application or Petition Fee (State Water Resources Control Board only)	\$850.00	\$ _____
☐ County documentary handling fee		\$ _____
☐ Other 0.00		\$ _____

PAYMENT METHOD:

☐ Cash ☐ Credit ☐ Check ☒ Other

TOTAL RECEIVED \$ _____ **\$0.00**

SIGNATURE X <i>Bridgette Evans</i>	AGENCY OF FILING PRINTED NAME AND TITLE <i>Bridgette Evans</i>	Deputy
--	---	--------

INDEX OF SHEETS

SHEET NO.	DRAWING NO.	DRAWING TITLE
1	T-1	TITLE SHEET, LOCATION MAP, SITE PLAN AND INDEX OF SHEETS

COUNTY OF YUBA
PROJECT PLANS FOR CONSTRUCTION OF
LOMA RICA ROAD
CULVERT REPLACEMENT PROJECT
YUBA COUNTY, CALIFORNIA
CONTRACT NO. 102-4237

TO BE SUPPLEMENTED WITH THE 2023 STANDARD PLANS AND SPECIFICATIONS
OF THE CALIFORNIA DEPARTMENT OF TRANSPORTATION
AND THE CURRENT YUBA COUNTY STANDARD PLANS AND SPECIFICATIONS



YUBA COUNTY SHALL NOT BE RESPONSIBLE FOR THE ACCURACY OR COMPLETENESS OF ELECTRONIC COPIES OF THIS PLAN SHEET.

NOTE: THE CONTRACTOR SHALL POSSESS THE FOLLOWING CONTRACTOR LICENSE(S) AT THE TIME THIS CONTRACT IS AWARDED:

A. GENERAL ENGINEERING




Monty Hansen
8/4/24

APPROVED BY: _____ DATE: _____

CHAIR, YUBA COUNTY
BOARD OF SUPERVISORS

APPROVED BY: _____ DATE: _____

SAMUEL L. BUNTON, P.E.
PUBLIC WORKS DIRECTOR
COUNTY OF YUBA RCE 91656

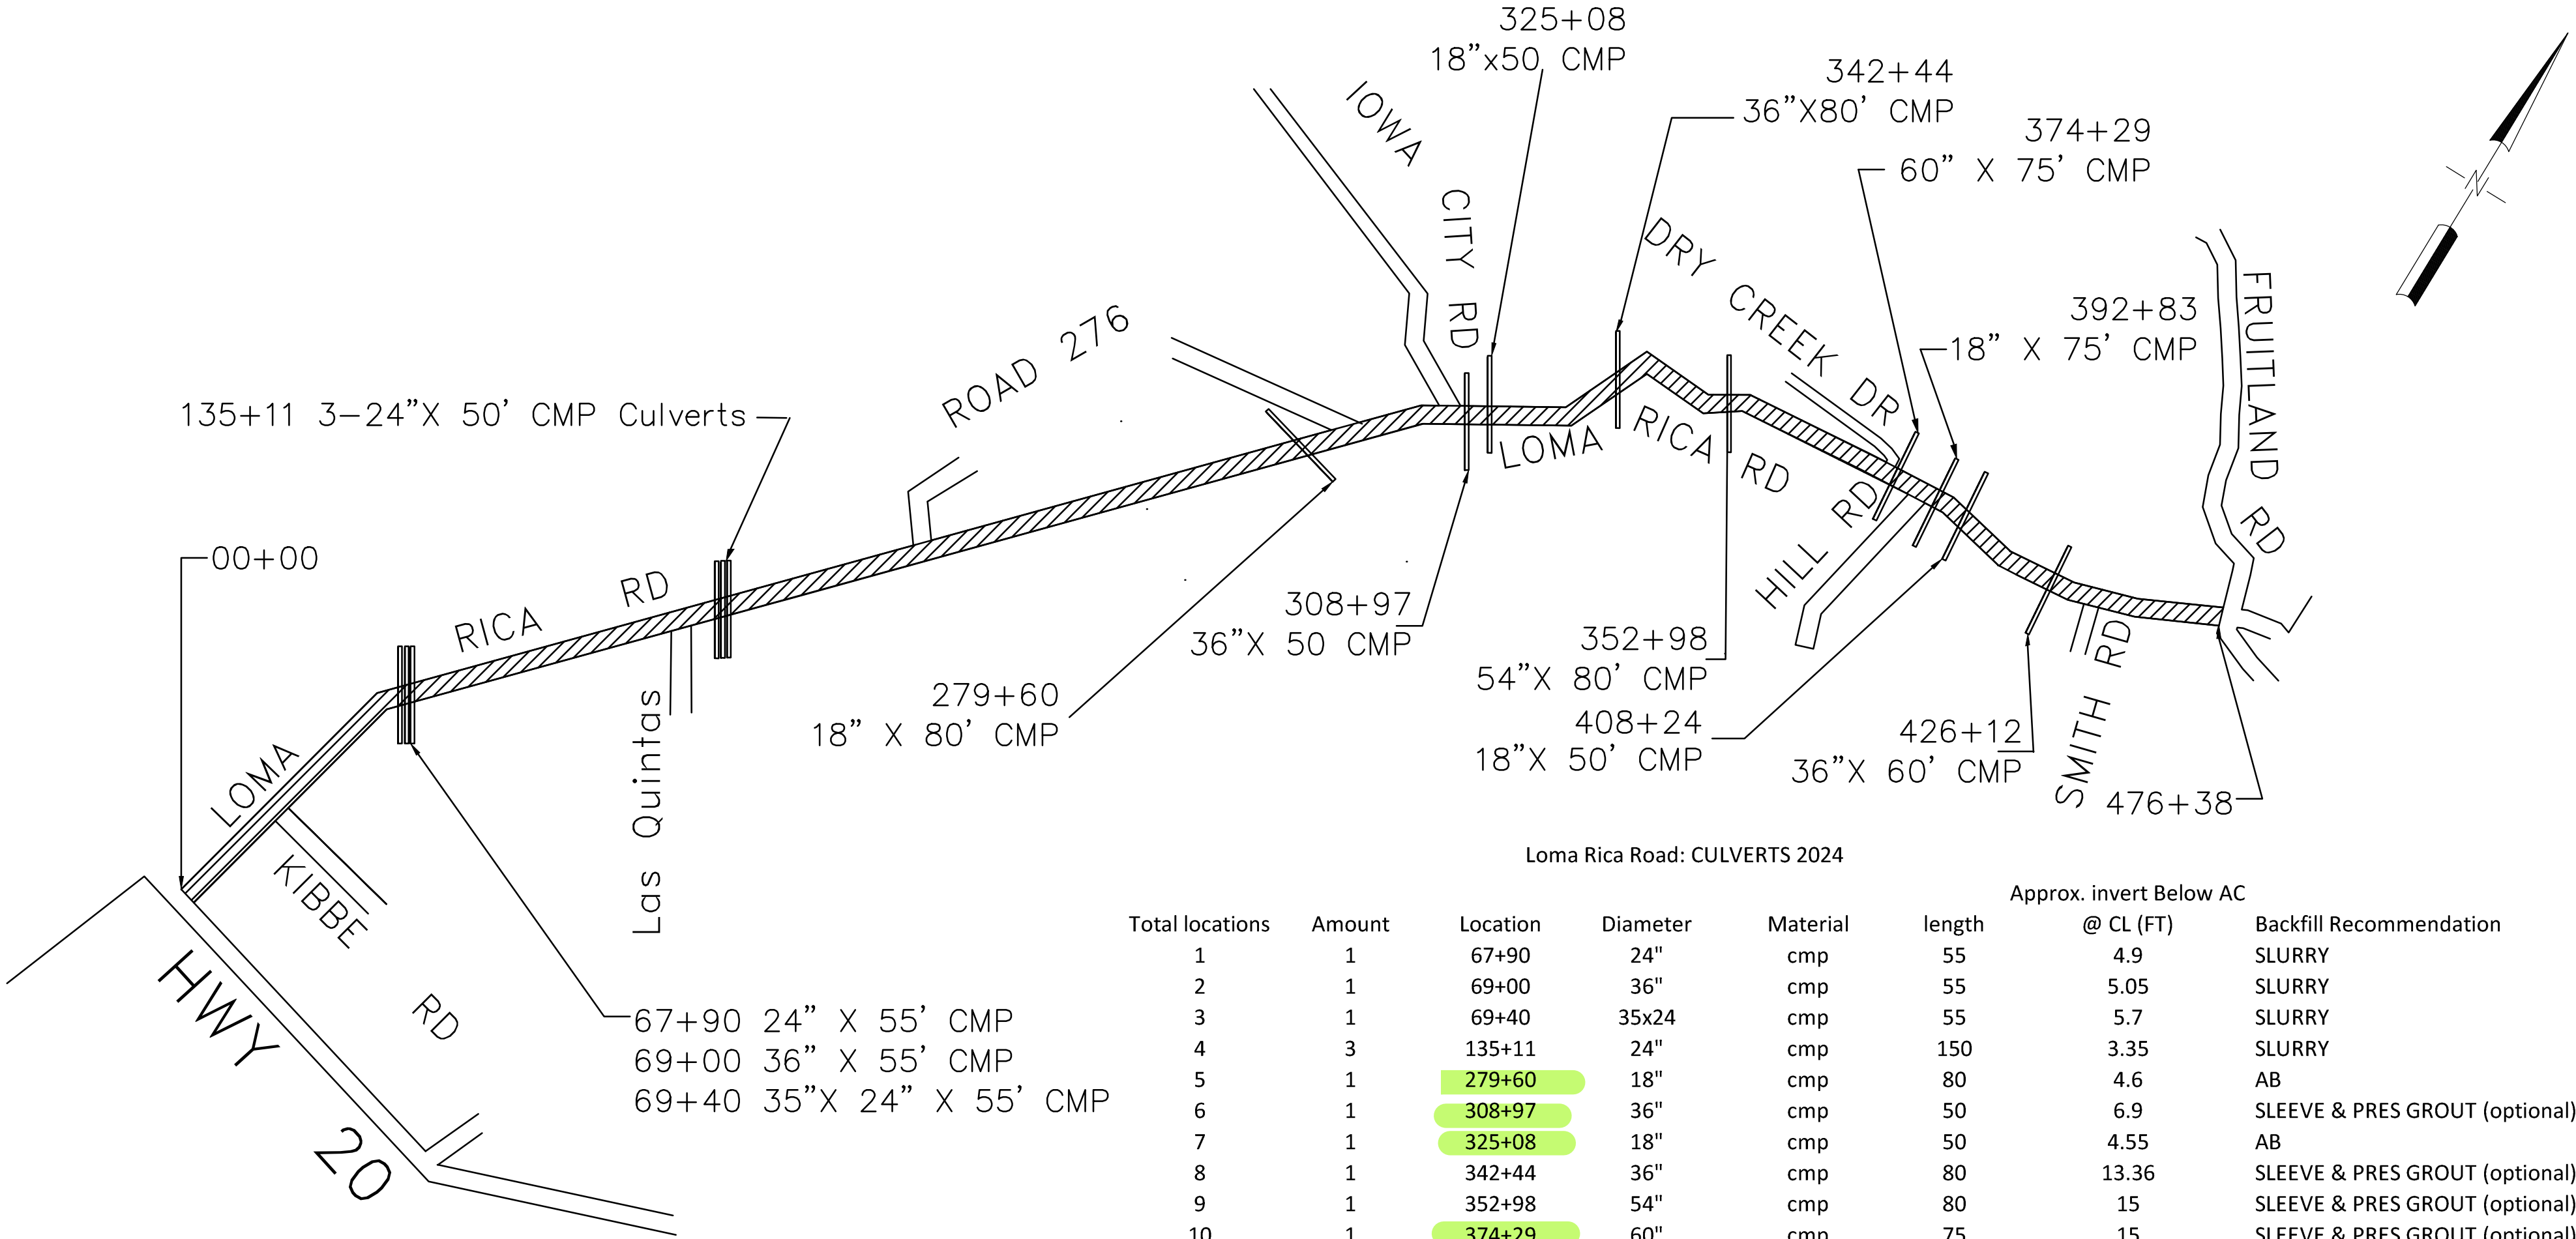

Loma Rica Road: CULVERTS 2024

Total locations	Amount	Location	Diameter	Material	length	Approx. invert Below AC @ CL (FT)	Backfill Recommendation
1	1	67+90	24"	cmp	55	4.9	SLURRY
2	1	69+00	36"	cmp	55	5.05	SLURRY
3	1	69+40	35x24	cmp	55	5.7	SLURRY
4	3	135+11	24"	cmp	150	3.35	SLURRY
5	1	279+60	18"	cmp	80	4.6	AB
6	1	308+97	36"	cmp	50	6.9	SLEEVE & PRES GROUT (optional)
7	1	325+08	18"	cmp	50	4.55	AB
8	1	342+44	36"	cmp	80	13.36	SLEEVE & PRES GROUT (optional)
9	1	352+98	54"	cmp	80	15	SLEEVE & PRES GROUT (optional)
10	1	374+29	60"	cmp	75	15	SLEEVE & PRES GROUT (optional)
11	1	392+83	18"	cmp	50	4.75	AB
12	1	408+24	18"	cmp	50	2.95	SLURRY
13	1	426+12	36"	cmp	60	5.25	SLURRY

size (Inches)	length (ft.)	Type
18	230	CMP
24	205	CMP
35x24	55	CMP
36	115	CMP
36	50	SLEEVE 7 PRES GROUT
36	80	SLEEVE 7 PRES GROUT
54	80	SLEEVE 7 PRES GROUT
60	75	SLEEVE 7 PRES GROUT

\$637,450.00 Total Eng Est

Basis of Stationing: Begin Stationing approx @ 00+00
(CA STATE ROUTE 20) North along existing roadway.



CONTRACTOR SHALL VERIFY THE LOCATION OF
ALL UTILITIES WITHIN THE PROJECT LIMITS.

NUMBER	DATE	DESCRIPTION	BY	REVISION BLK.	BENCHMARK ELEVATION:	SITE PLAN	COUNTY OF YUBA DEPARTMENT OF PUBLIC WORKS	DRAWN BY: WNOTT DESIGNED BY: WNOTT CHECKED BY: MHANSEN SUBMITTED BY: S. BUNTON	SCALE: HORIZONTAL NTS VERTICAL N/A	LOMA RICA ROAD CILVERT REPLACEMENT PROJECT	DWG # T-1
					SEE SHEET SC-1	NOT TO SCALE	915 8th ST, SUITE 125 MARYSVILLE, CA 95901 (530) 749-5420 (530) 749-5424 FAX	PLOT DATE: 9/4/24 RCE NO. 60005		TITLE SHEET	SHEET 1 OF 1